


T.28S.,R.8W.,W.M.

Section 36

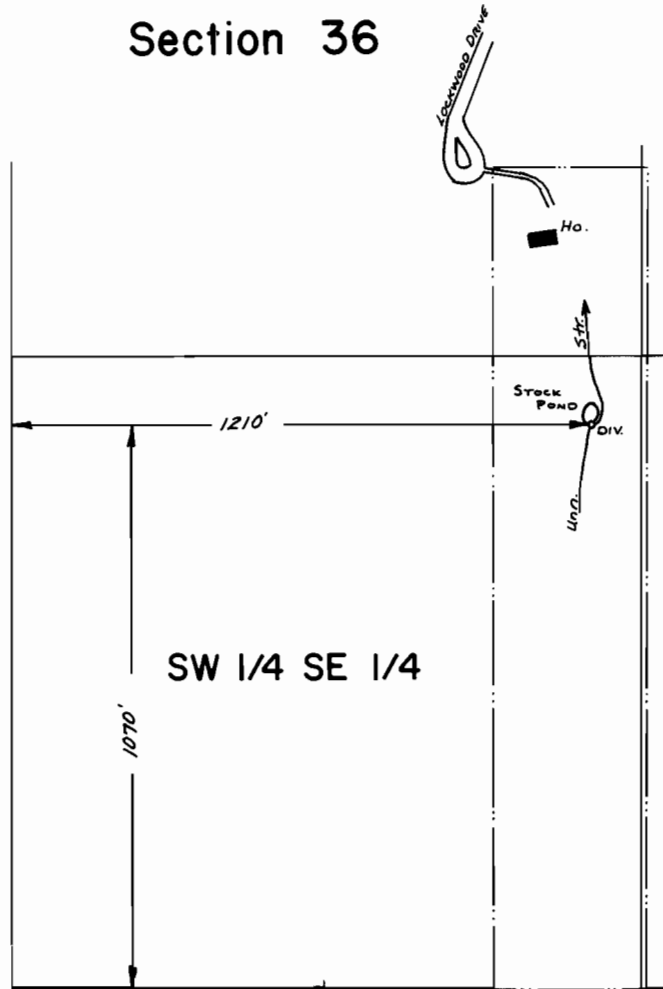

SCALE: 1" = 400'

**FINAL PROOF SURVEY**  
UNDER

Application No. 56044 Permit No. 42168  
IN NAME OF

CHRISTA E. HANSEN

Surveyed April 8, 1980, by J.S. DONALDSON