


T.29S.,R.6W.,W.M.

SECTION 30

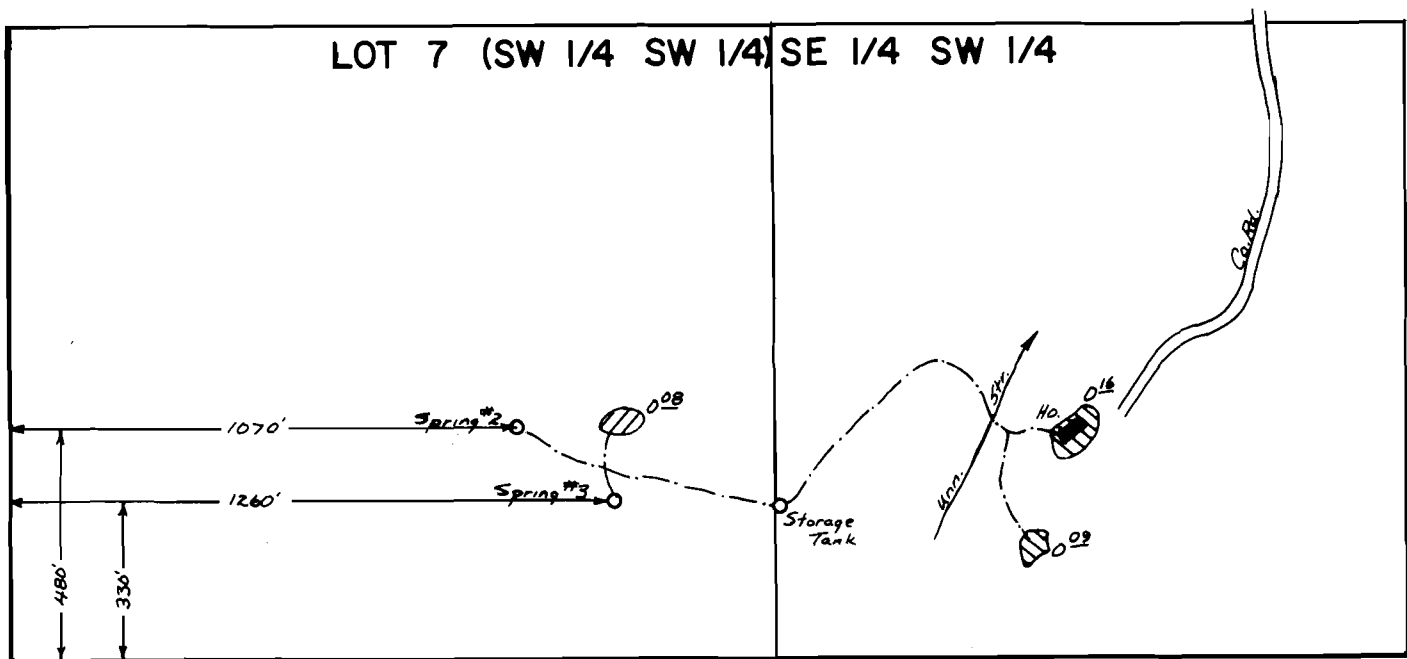

FINAL PROOF SURVEY
UNDER

Application No. 56538 Permit No. 42556.....
IN NAME OF

ROBERT T. WHITNEY

Surveyed April 10, 1980, by J. S. DONALDSON