


T. 32S., R. 4W., W.M.

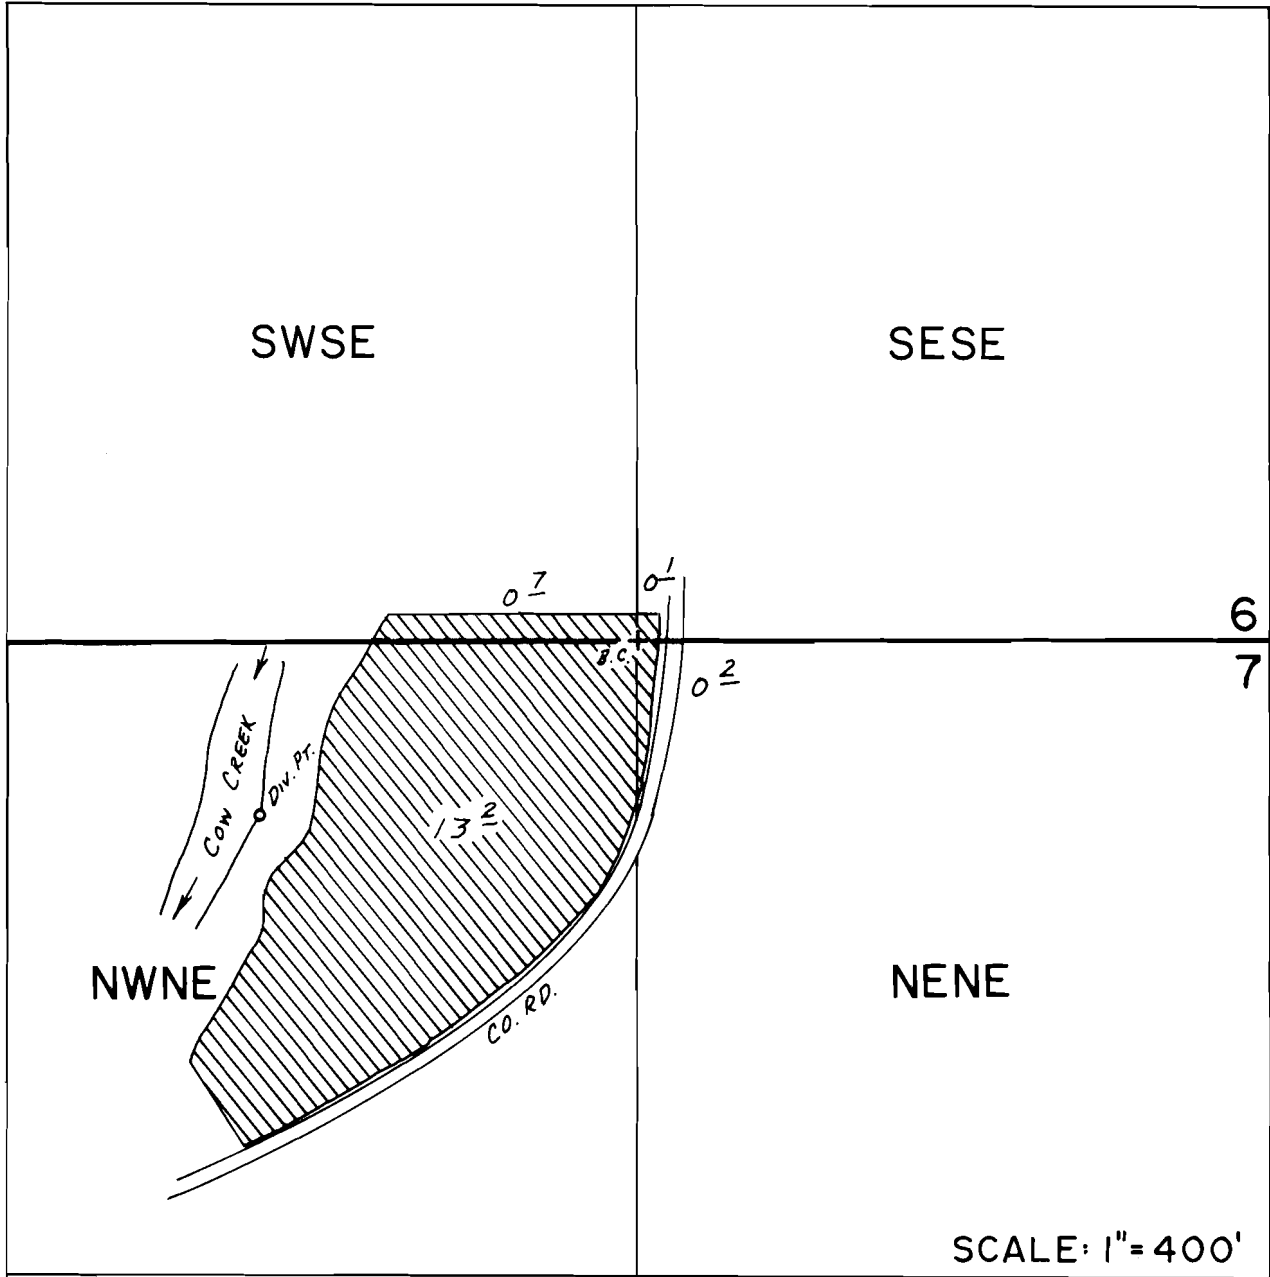

DIV. PT. LOC.: 360'S. & 790'W. FROM NE COR. NW 1/4 NE 1/4 SEC. 7.

**FINAL PROOF SURVEY**  
UNDER

Application No. 56662, Permit No. 42678.....  
IN NAME OF

.....GARETH RICE.....

Surveyed JULY 7... 1980, by J.S. DONALDSON