


T.27S.,R.3W.,W.M.

Section 3

NE 1/4 NE 1/4

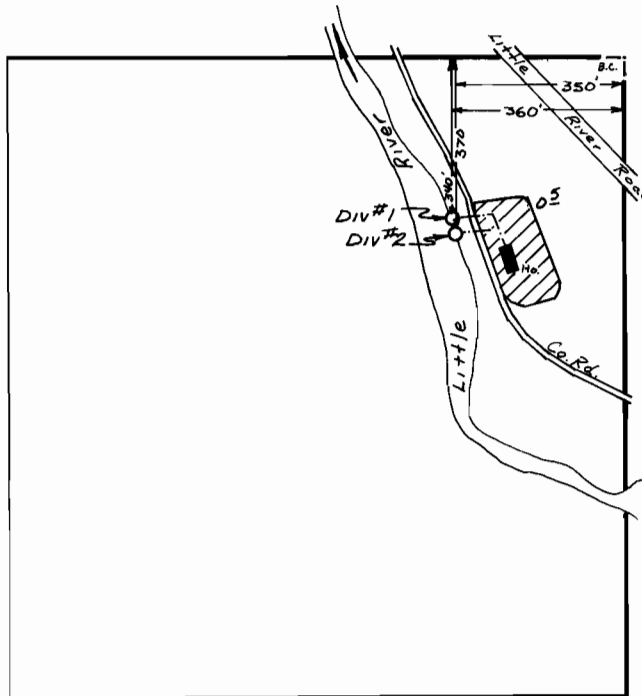

SCALE: 1" = 400'

**FINAL PROOF SURVEY**  
UNDER

Application No. 57390.. Permit No. 4323!.....  
IN NAME OF

**ROBERTA A. GRIMES**

Surveyed May 14 1980., by J.S. DONALDSON