


T.26S. R.4W. W.M.

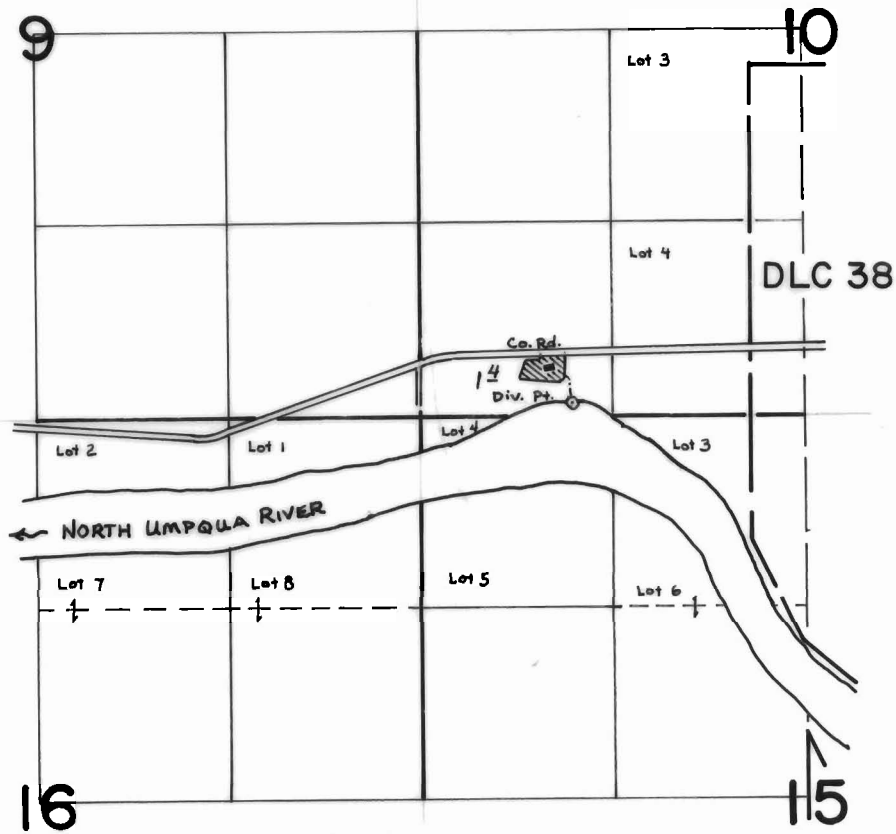

Div. Pt. Located: $80^{\circ}N \frac{1}{2} 105^{\circ}E$ from NW Cor. of Sec. 15

SCALE: 4" = 1 mile

FINAL PROOF SURVEY
UNDER

Application No. 57585 Permit No. 43365
IN NAME OF

GORDON & FILOMENA HOWE

Surveyed April 29, 1980, by S. Donaldson.....