


T.26S.,R.3W.,W.M.
SEC. 27

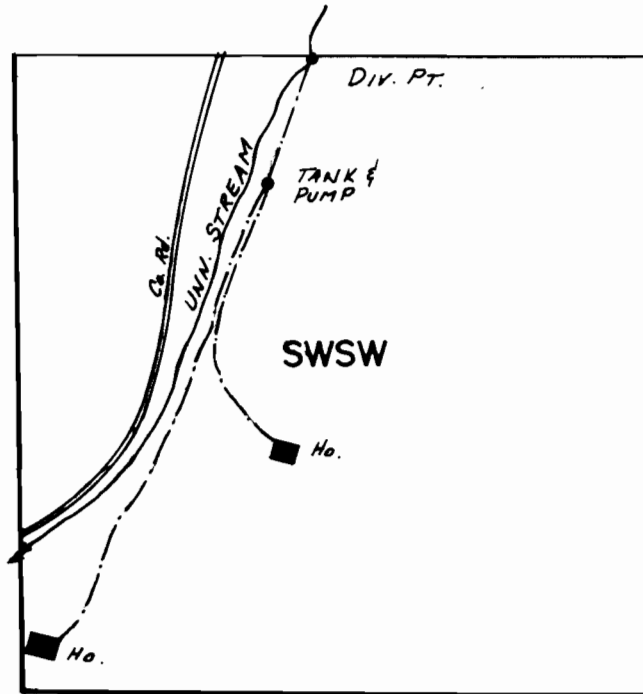

DIV. PT. Loc.: 1320' N. & 600' E. FROM SW COR. SEC. 27.

SCALE: 1" = 400'

FINAL PROOF SURVEY
UNDER

Application No. 58151... Permit No. 43789...
IN NAME OF

MARTHA BAKEMAN & PETER & MARIE MATIJAKOWICZ

Surveyed APR. 28, 1980, by J.S. DONALDSON