


T. 22S., R. 12W., W.M.

SEC. 33

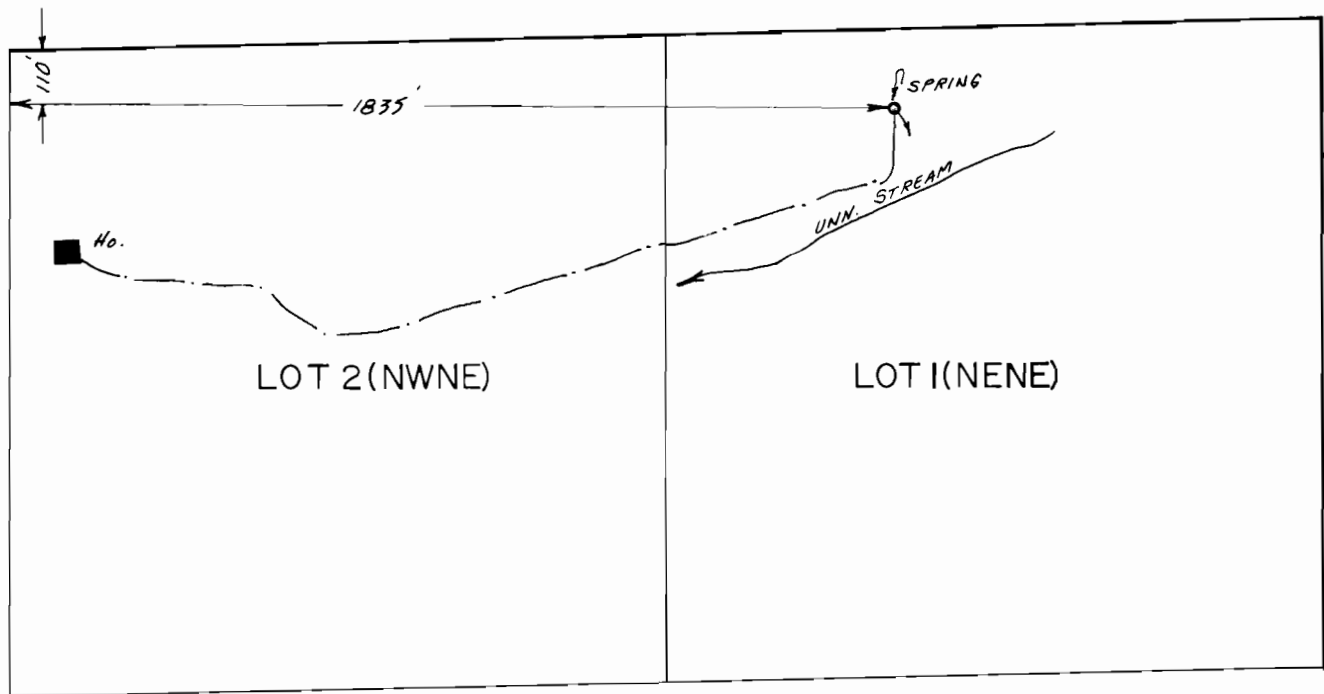

SCALE: 1" = 400'

FINAL PROOF SURVEY
UNDER

Application No. 57731.... Permit No. 43794.....
IN NAME OF

.....DOLLY JEAN SMITH.....

Surveyed JUNE 3, 1980, by J.S. DONALDSON