


T. 29 S., R. 5 W., W.M.

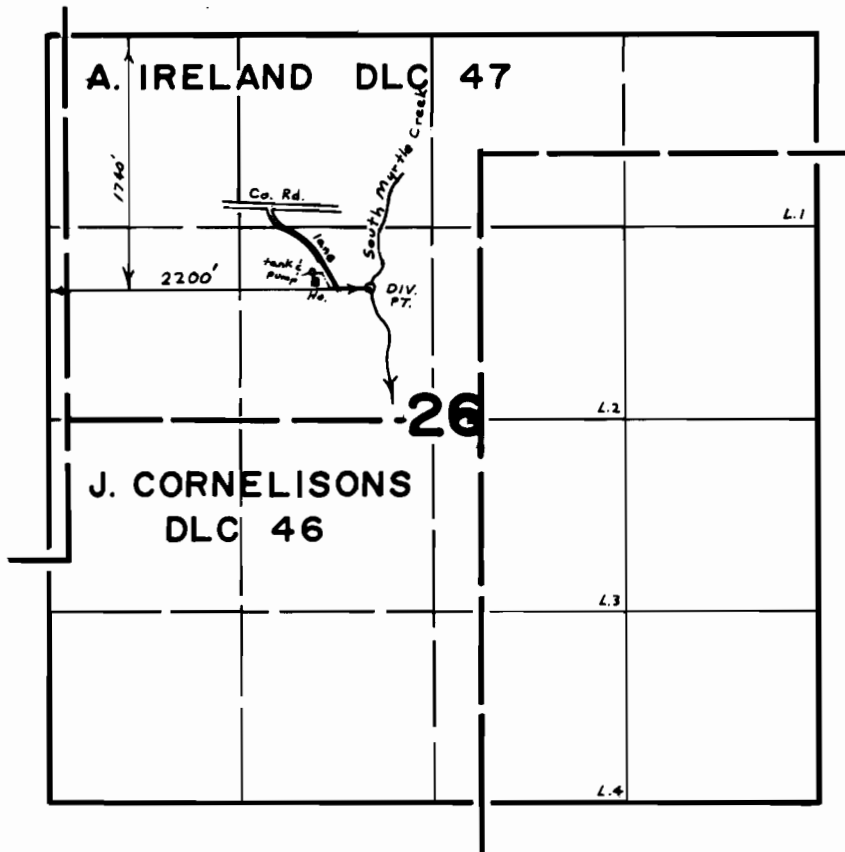

SCALE 4" = 1 mile

FINAL PROOF SURVEY
UNDER

Application No. 57801 Permit No. 43899
IN NAME OF

.....DON & THERESA HILLIARD.....

Surveyed Dec. 11, 1979, by S. Donaldson...