


T.30S.,R.4W.,W.M.

Section 22

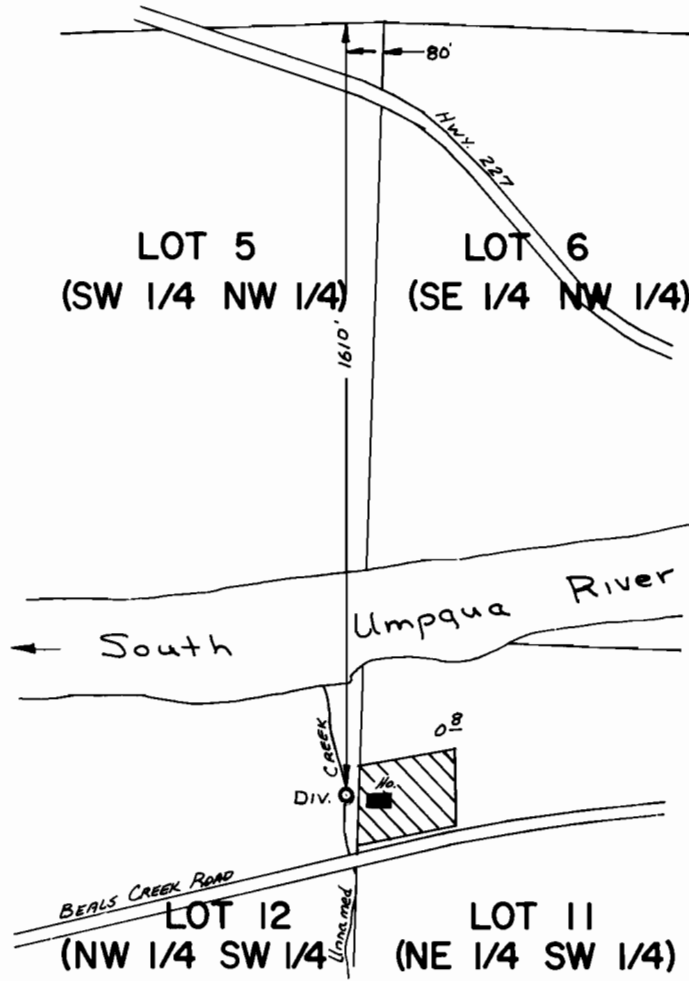

SCALE: 1"=400'

FINAL PROOF SURVEY  
UNDER

Application No. 58430 Permit No. 43987  
IN NAME OF

BARBARA J. WHETZEL

Surveyed June 26 1980, by J. S. DONALDSON