


T.26S.,R.6W.,W.M.

Section 14

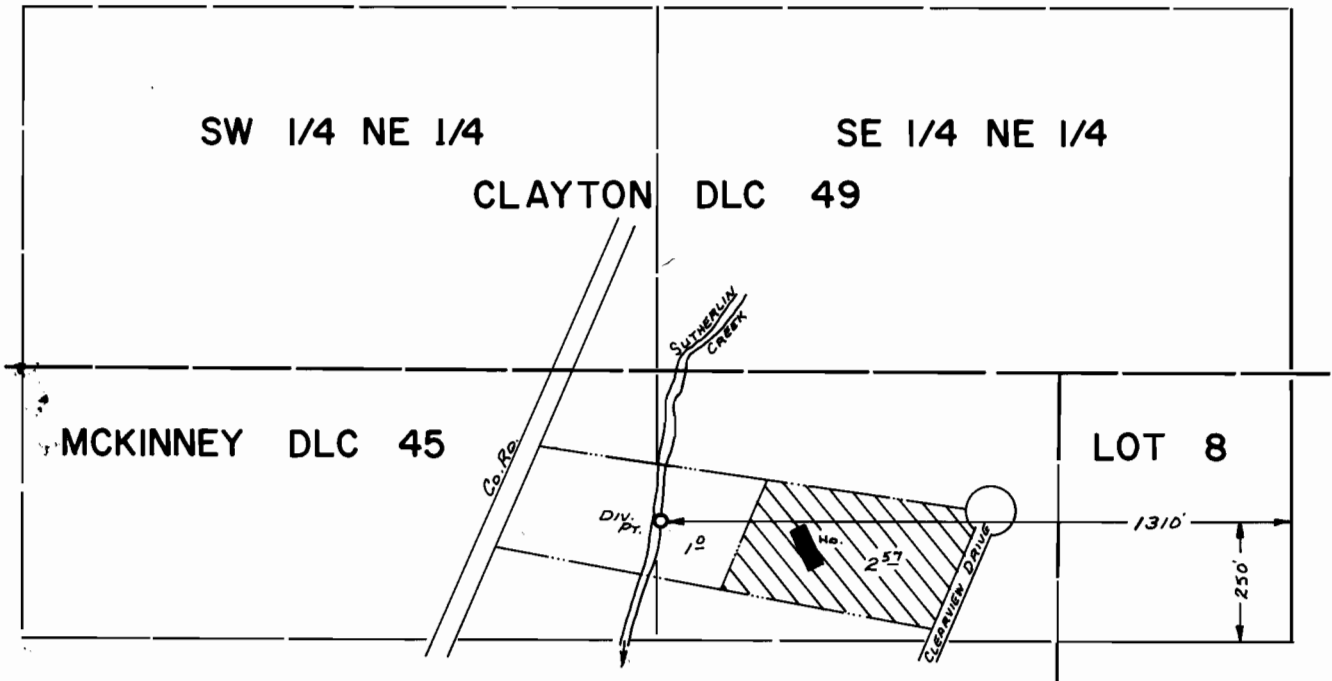

SCALE: 1" = 400'

FINAL PROOF SURVEY
UNDER

Application No. 58720 Permit No. 44293

IN NAME OF

ERNEST P. HOLLAND

Surveyed May 13 1982, by L.M. TOLL