


T. 26S., R. 3W., W.M.

SEC. 10

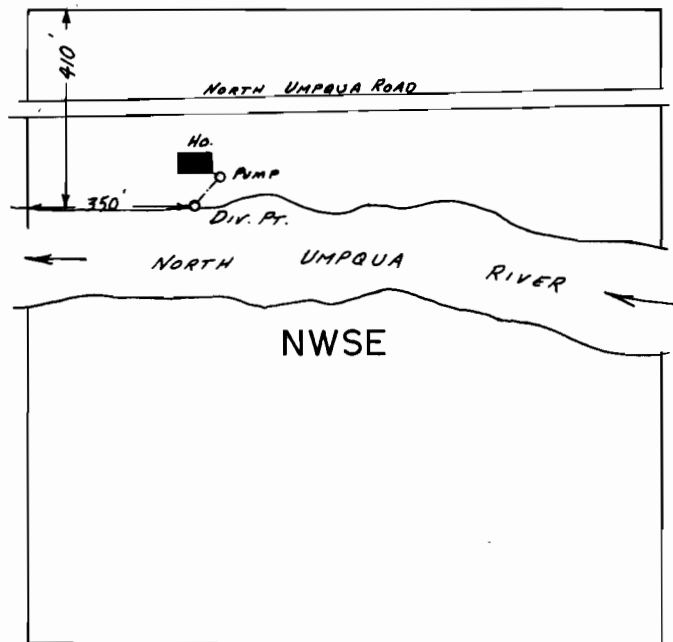

SCALE: 1" = 400'

FINAL PROOF SURVEY

UNDER

Application No. 58947... Permit No. 44442.....

IN NAME OF

.....JAMES & JEANNE WALLACE.....

Surveyed APR. 17... 19.80, by J.S. DONALDSON

Ball