


T. 26S., R. 7W., W.M.

SEC. 24

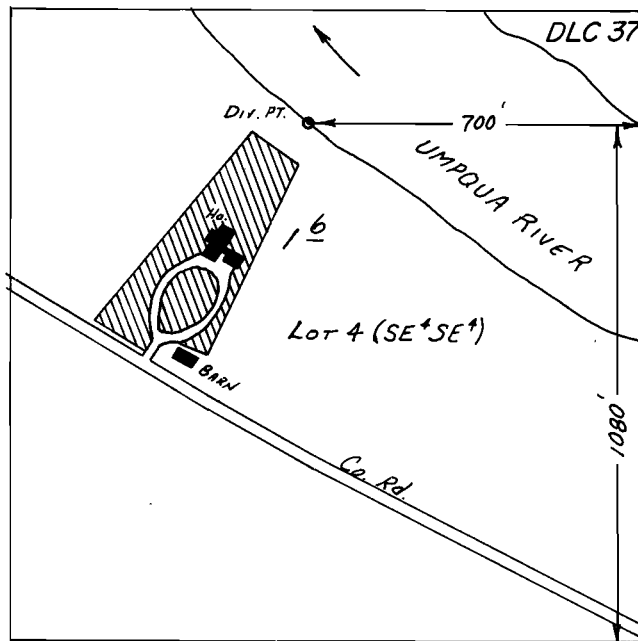

SCALE: 1" = 400'

**FINAL PROOF SURVEY**  
UNDER

Application No. 5883!... Permit No. 44578.....  
IN NAME OF

.....DR. THOMAS M. HOBART.....

Surveyed MAR. 26. 19.80, by J.S. DONALDSON