


T.26S., R.3W., W.M.  
SEC. 1

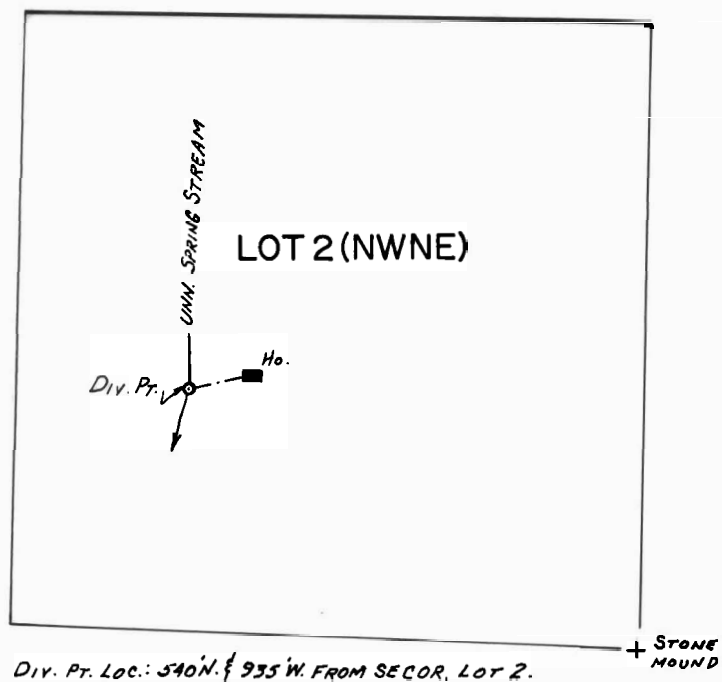

SCALE: 1" = 400'

**FINAL PROOF SURVEY**  
UNDER

Application No. 59424 Permit No. 44765.....  
IN NAME OF

HARLESS A. BACHMAN

Surveyed MAY 8..... 1980., by J.S. DONALDSON