


4990
5442

N.E. 1/4 of the S.E. 1/4 Sec. 30, T. 34 S., R. 19 E.
W.M.

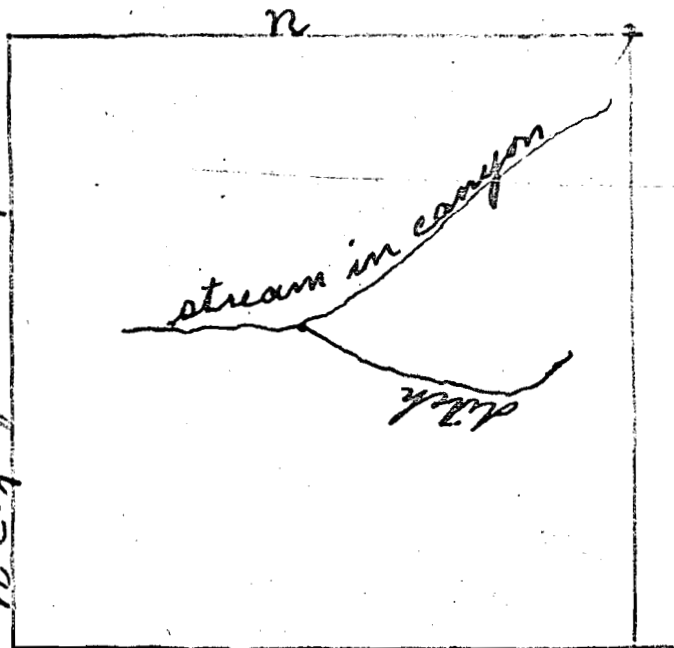

By W^m E. Koenig
Paisley
Oregon.

OFFICE OF STATE ENGINEER

RECEIVED

MAR 21 1921

SALEM, OREGON

Application No.
Permit No.

7735

4990