


P-43525

T. 13S, R. 30E W.M.

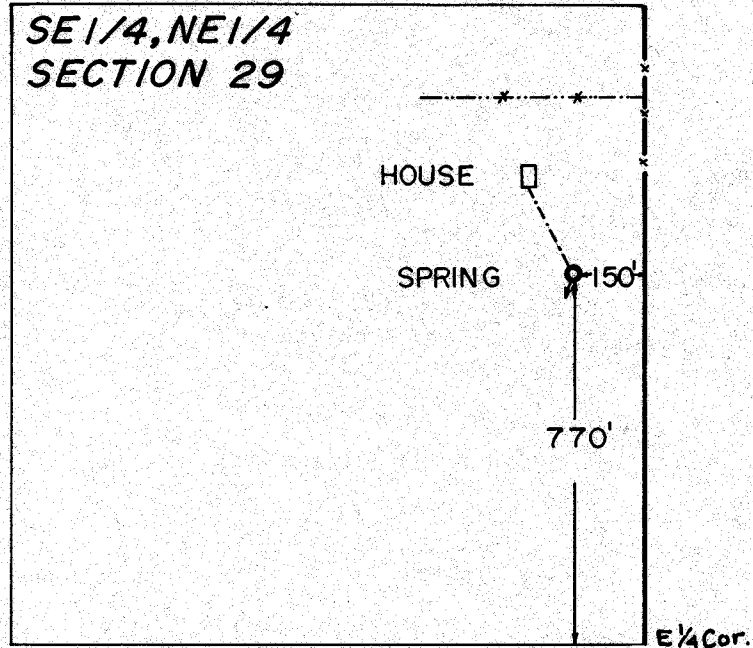

Scale - 1" = 400'

FINAL PROOF SURVEY
UNDER

Application No. 57180... Permit No. 43525...
IN NAME OF

.....DONALD E. BOYER.....

Surveyed July 18... 1979., by S.C. BROWN.....

P15-1979-B *llc.*