


T. 39 S., R. 3 W., W.M.

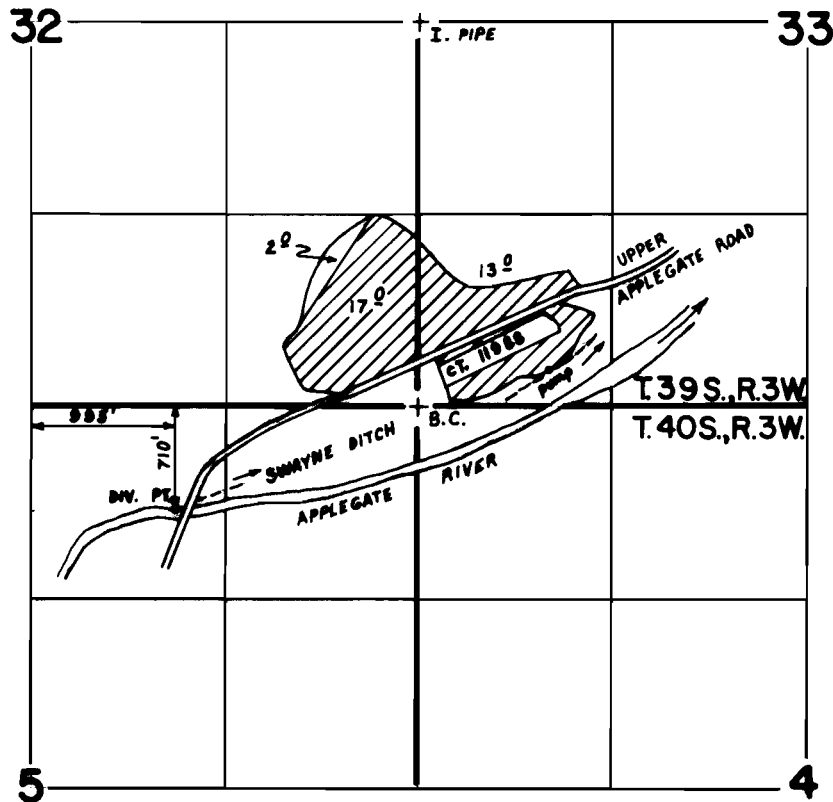

SCALE: 4" = 1 MILE

FINAL PROOF SURVEY UNDER

Application No. 60424 Permit No. 45139
IN NAME OF

DAVID B. WINNINGHAM

Surveyed MAY 18 1982, by BRUCE R. SUND