


G-6654
54425

T. 25 S., R. 15 E., W.M.

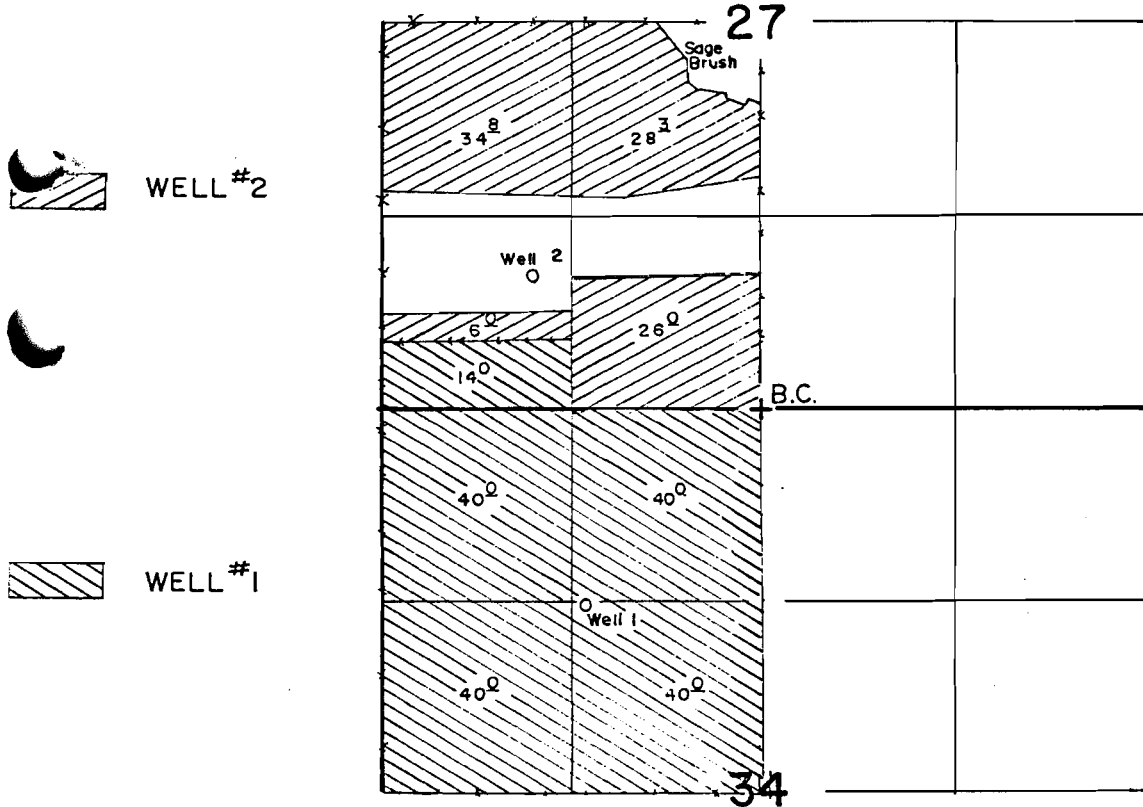

Well 1 Loc.: 1340' S. & 1200' W. from the N 1/4 Cor. Sec. 34

Well 2 Loc.: 900' N & 1580' W. from the N 1/4 Cor. Sec. 34

FINAL PROOF SURVEY UNDER

G- 8672
Application No. G- 7254 Permit No. G-6654.....
IN NAME OF

G-8097 (Cont 54427)

GEORGE H. WARMINGTON.....

Surveyed OCT. 20, 1983, by L. TOLL.....