


G-8097  
54427  
T5803  
55700  
T5103

# T. 25 S., R. 15 E., W.M.

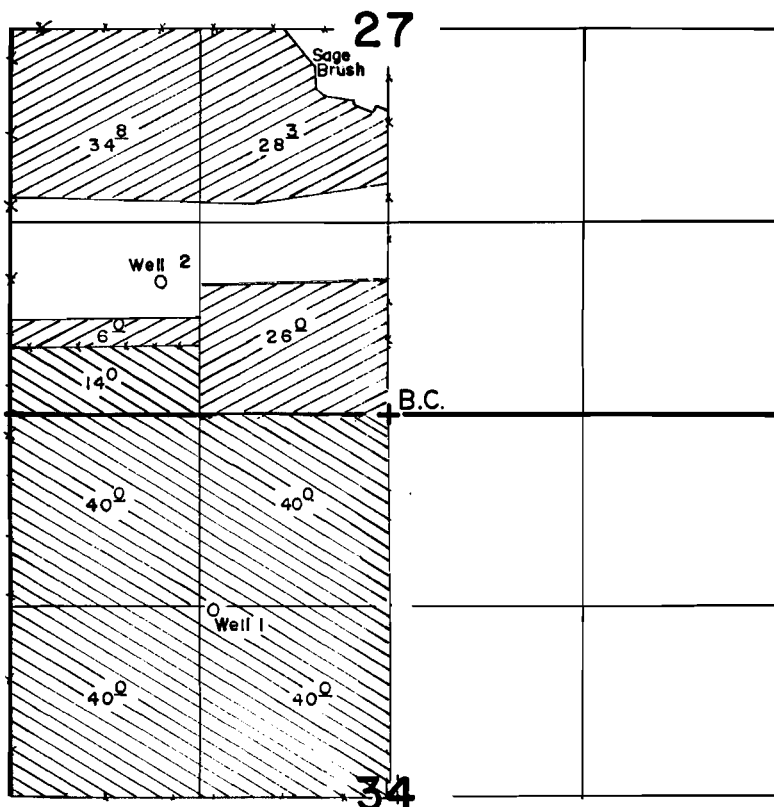

Well 1 Loc.: 1340' S. & 1200' W. from the N 1/4 Cor. Sec. 34  
Well 2 Loc.: 900' N & 1580' W. from the N 1/4 Cor. Sec. 34

## FINAL PROOF SURVEY UNDER

Application No. G-8672 Permit No. G-8097  
G-7254 G-6654  
IN NAME OF

GEORGE H. WARMINGTON

Surveyed OCT. 20, 1983, by L. TOLL