


G-9544
54428

T.26S.,R.17E.,W.M.

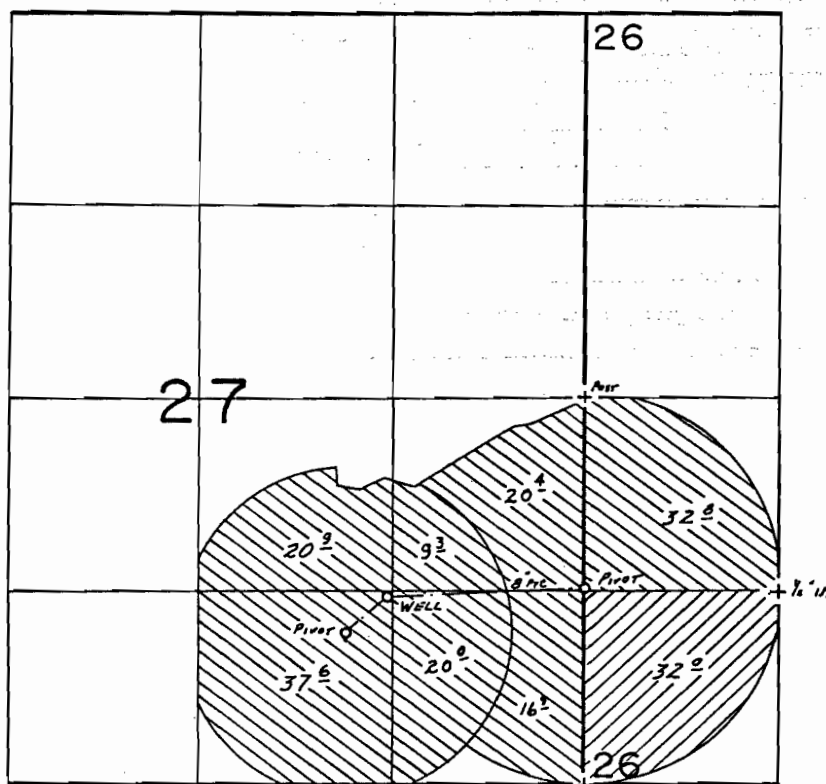

WELL LOC: 1280' N. & 1340' W. FROM S.E. COR. SEC. 27

Scale: 1"=1320'

FINAL PROOF SURVEY UNDER

G-7503 G-6983
Application No. G-9800 Permit No. G-9544.....
IN NAME OF

NILO J. & MARY JANE WIDENOJA

Surveyed OCT. 11, 1984, by B.W. BISHOP.....

