


T.17S. R.1W. W.M.

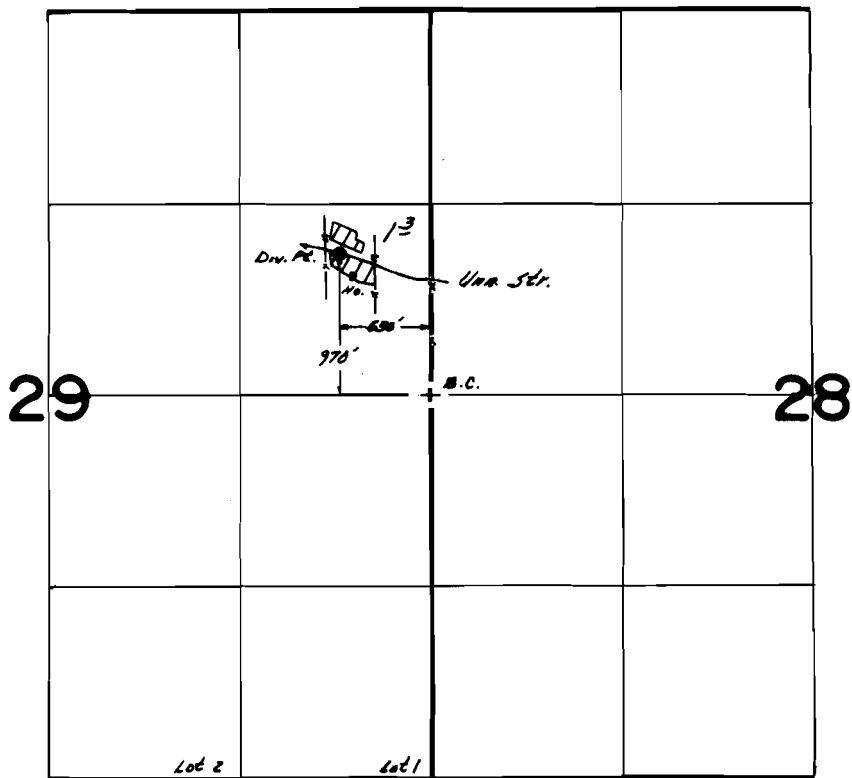

FINAL PROOF SURVEY
UNDER

Application No. 53574. Permit No. 38226.....
IN NAME OF

.....DOUGLAS JAMES DENNETT.....

Surveyed June..28. 1979., by S.C.BROWN.....