


T. 21 S., R. 2 W., W.M.

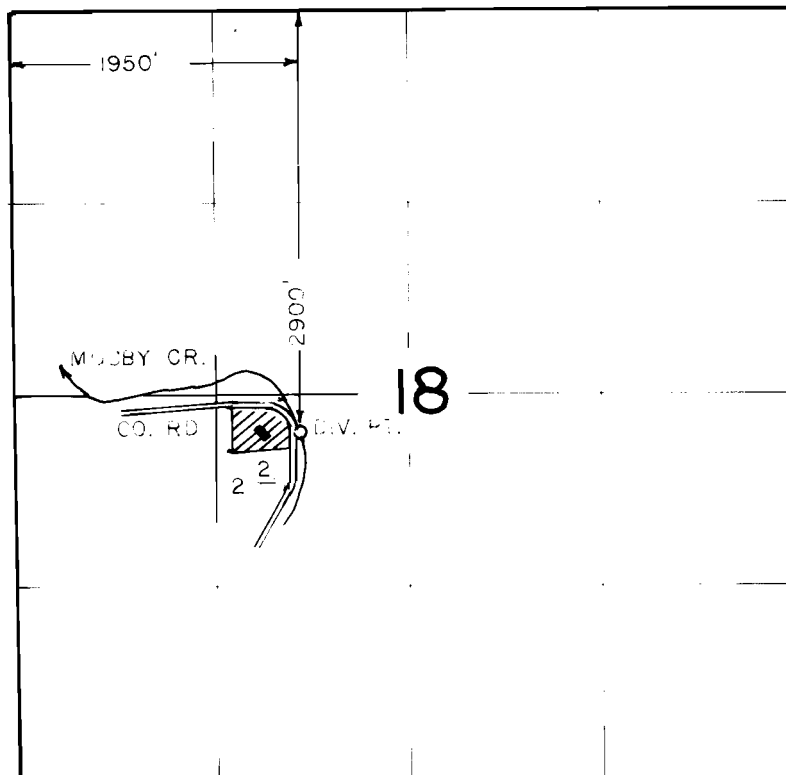

SCALE
1" = 1320'

FINAL PROOF SURVEY
UNDER

Application No. 52474.. Permit No. 39455.....
IN NAME OF

JOHN & JEANNE M. PINGREE

Surveyed AUG 30 1984, by P. PAGTER