


T .16S.R.3W. W.M.

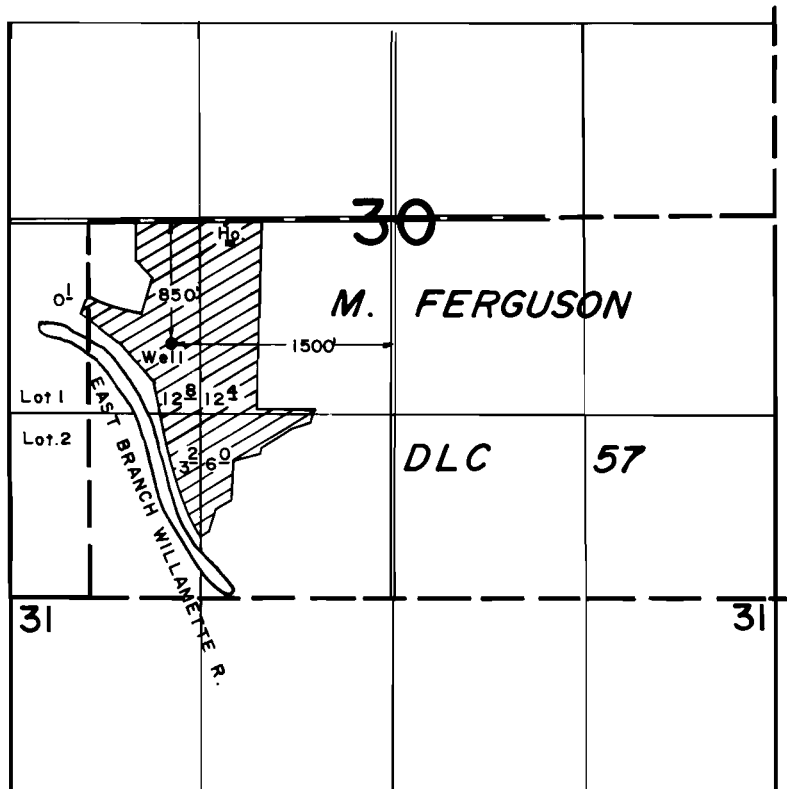

FINAL PROOF SURVEY
UNDER

Application No. G-8884. Permit No. G-8360...
IN NAME OF
LEON H. & LILY E. COLTHAR,—
.....**DAVID L. & LOYCE E. BIXLER**

Surveyed May...17... 1979., by S.C.BROWN.....