


T.12S., R.11W., W.M.

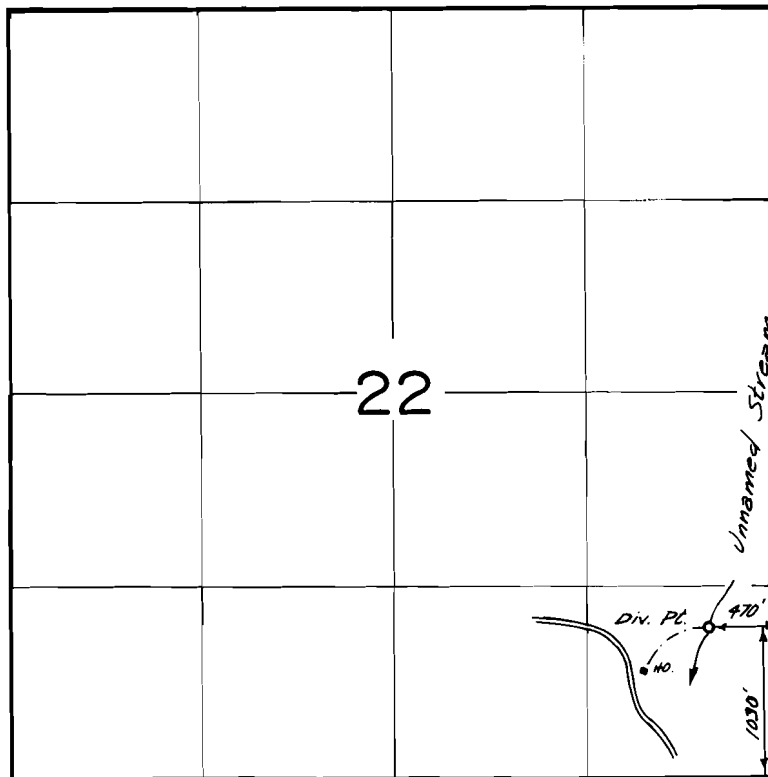

FINAL PROOF SURVEY
UNDER

Application No. 57485 Permit No. 43289
IN NAME OF
DELANO EDWARD SANDERS

Surveyed Sept 26, 1979, by AC Brown