


# T.10S.,R.2W.,W.M.

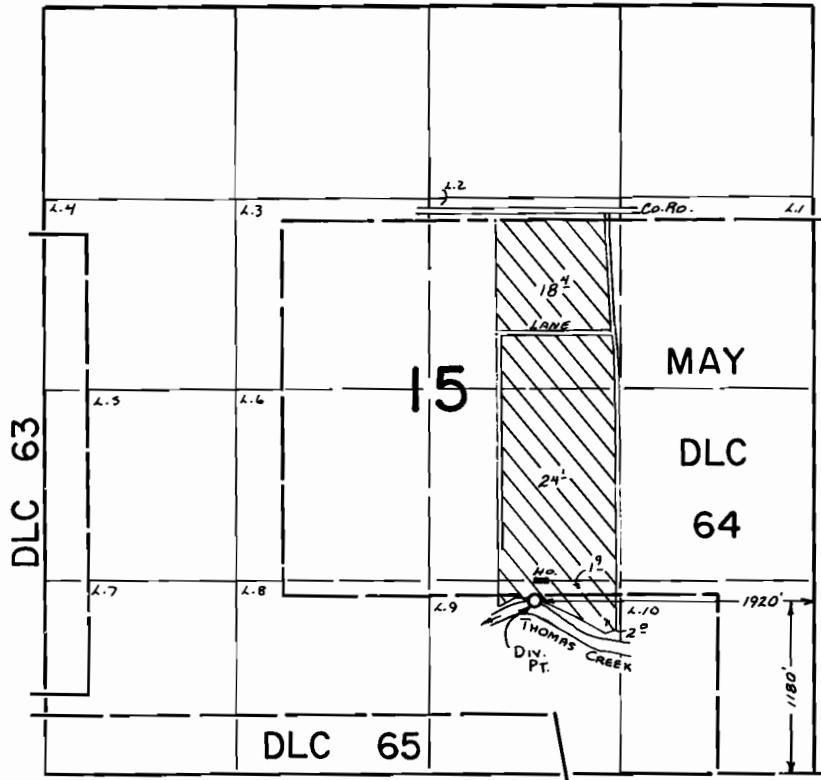

## FINAL PROOF SURVEY UNDER

Application No. 49314 Permit No. 36973  
IN NAME OF

EDWARD L. BRAHMER

Surveyed July 1, 1982, by L. M. TOLL