


# T.IOS.,R.IW.,W.M.

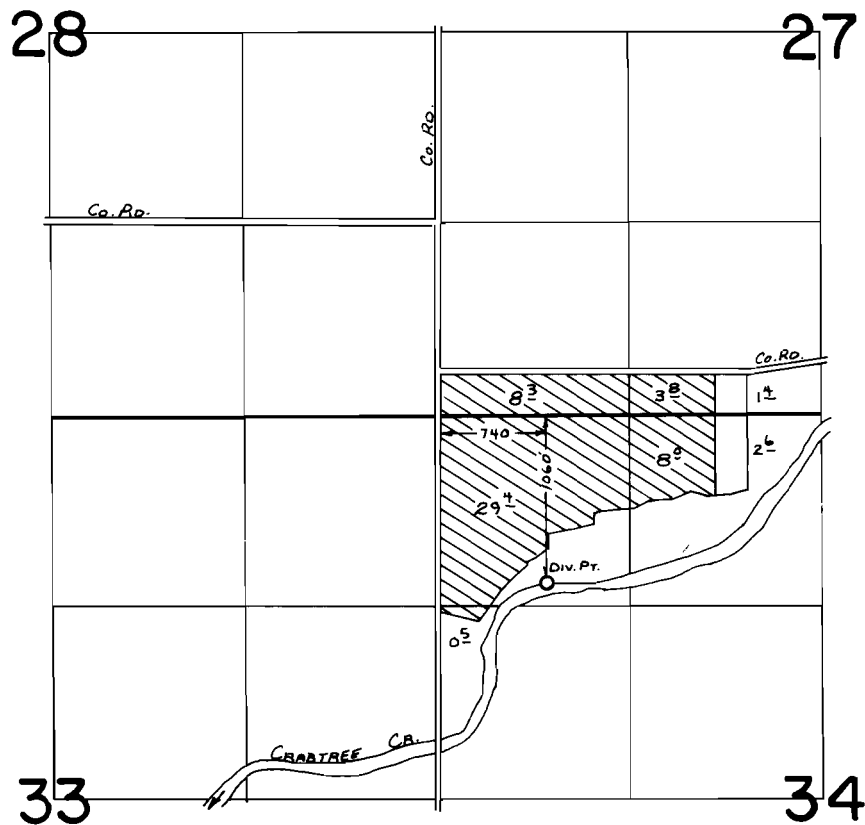

## FINAL PROOF SURVEY UNDER

Application No. .54039. Permit No. .40417.....  
IN NAME OF

.....**GLENN O. CLAYTON**.....

Surveyed .June.2... 19.82., by .L.M.TOLL.....