


T.4S.,R.2W.,W.M.

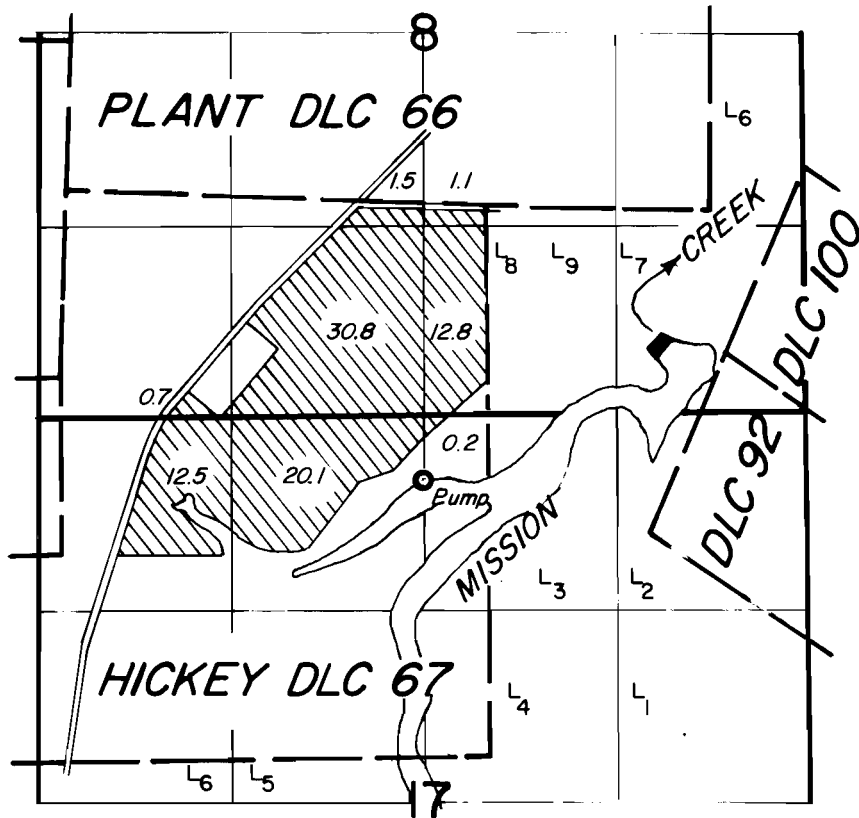

Pump Loc. : 1900' N. & 450' W. from SE Cor. Hickey DLC 67.

Dam Loc. : within Lot 7 (SE 1/4 SE 1/4) Sec. 8.

FINAL PROOF SURVEY UNDER

Application No. 51921..... Permit No. 39064.....
IN NAME OF

Gerald P. & Kathleen A. Mullen

Surveyed AUG. 29, 1979, by *[Signature]*.....