


T. 9 S., R. 2 W., W.M.

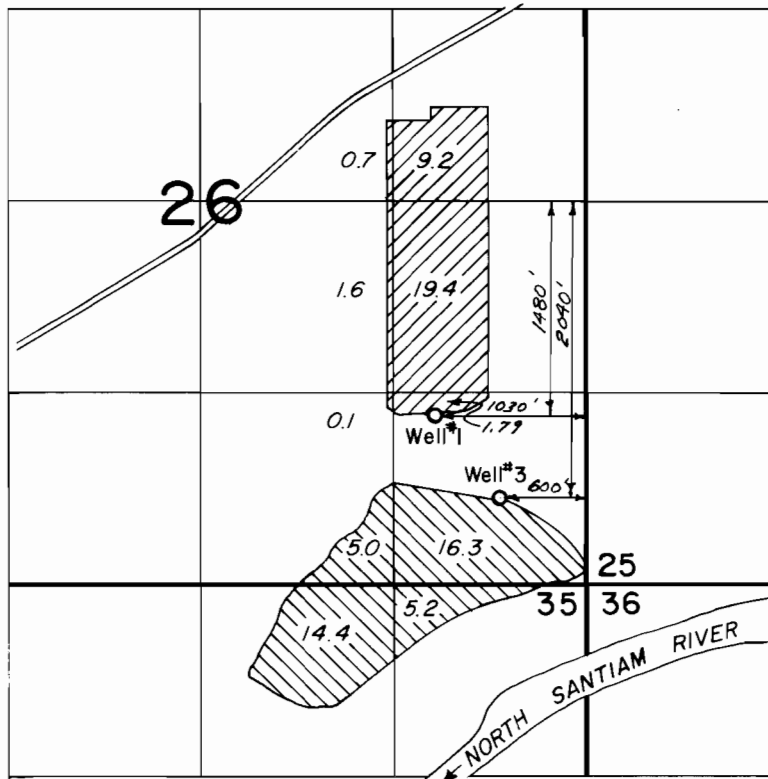

FINAL PROOF SURVEY UNDER

Application No. G-7824 Permit No. G-7271

IN NAME OF

ROBERT J. KOENIG

Surveyed OCT. 5., 1979, by *[Signature]*