


T.IN.R.3W.W.M.

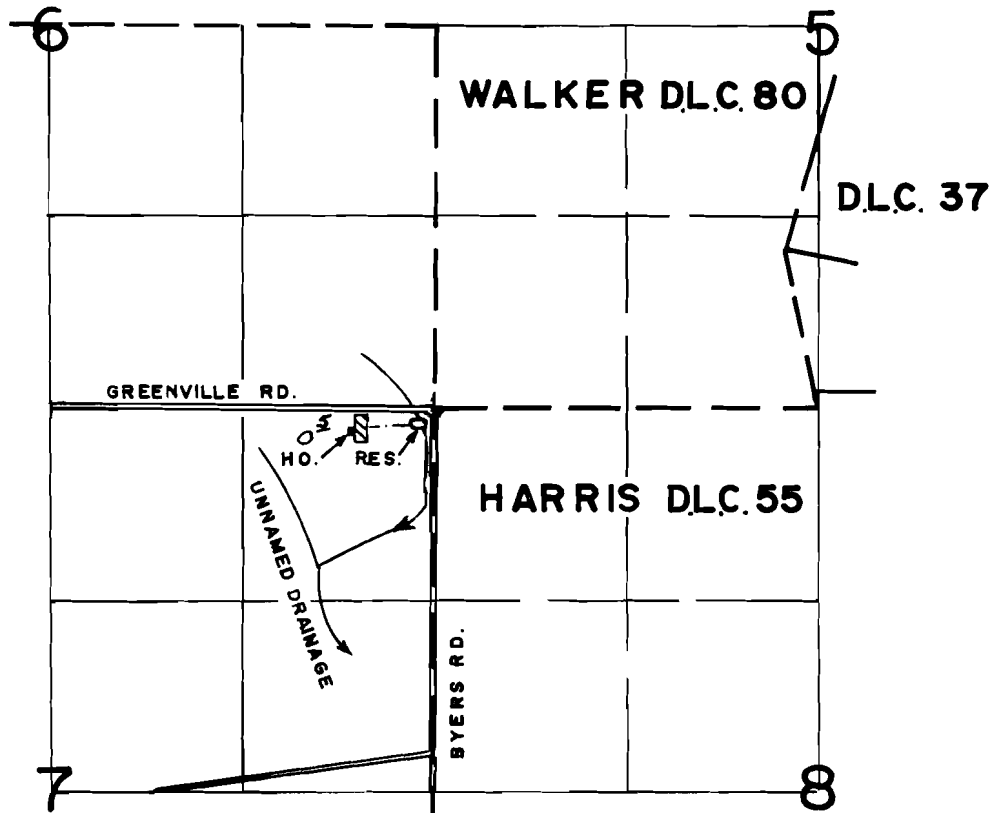

DIV. PT. LOCATED 150'S. & 200'W. FROM NE. COR. SEC. 7

FINAL PROOF SURVEY UNDER

R-54199

R-6472

Application No. 54200 Permit No. 40586.....

IN NAME OF

..... LYLE MEEUWSEN

Surveyed MAY...3... 19..79 by R.G.MUCKEN...