


T.I.S.R.4W.W.M.

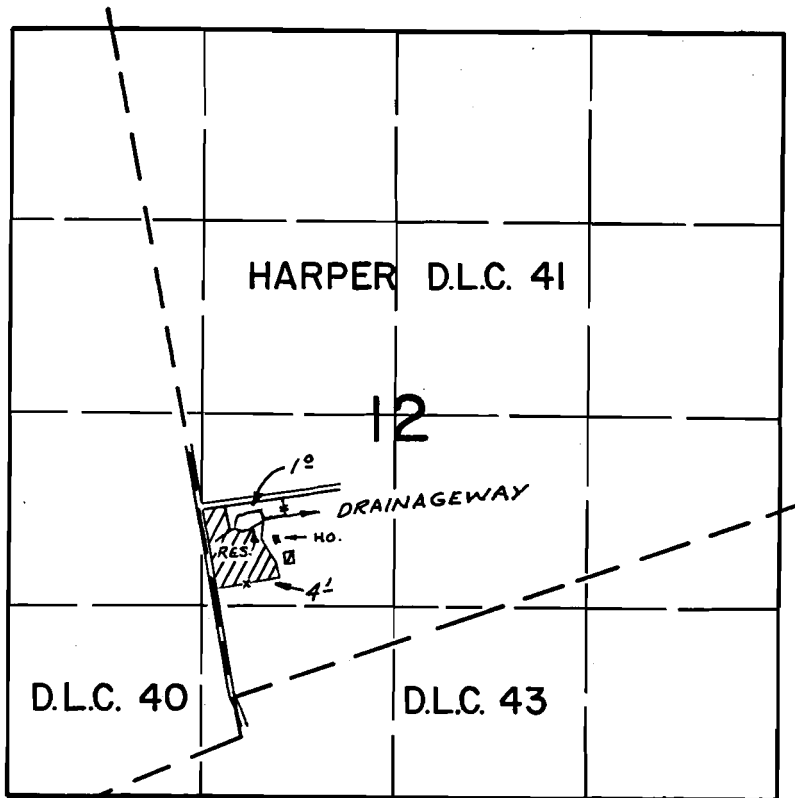

DIV. PT. Loc: 1230' N. & 200' E. FROM S.W. COR. HARPER D.L.C. 41

FINAL PROOF SURVEY UNDER

Application No. *R-48876* Permit No. *R-5932*
48877 *36622*
IN NAME OF

ROGER GENE RITCHEY

Surveyed *APR. 25 1979*, by *R. MUCKEN*