


T.1S.R.4W.W.M.

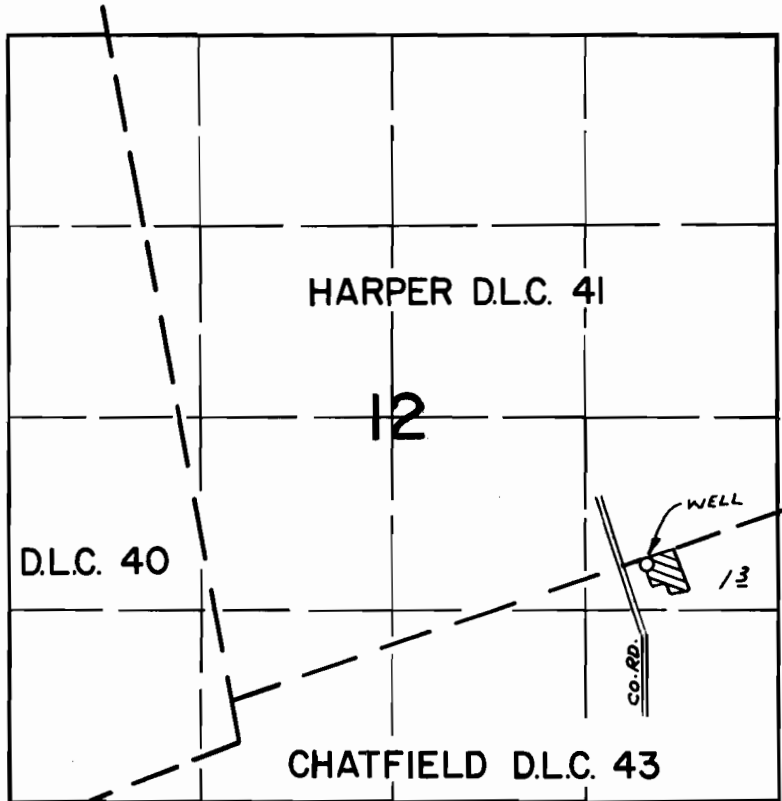

WELL LOC: 940' N. & 2840' E. FROM S.W. COR. HARPER. D.L.C. 41

FINAL PROOF SURVEY UNDER

Application No. G-7245 Permit No. G-6649
IN NAME OF

LARRY WILLIAMS

Surveyed APR 25, 1979, by R. MUCKEN