


T. 3 S. R. 4 W. W.M.

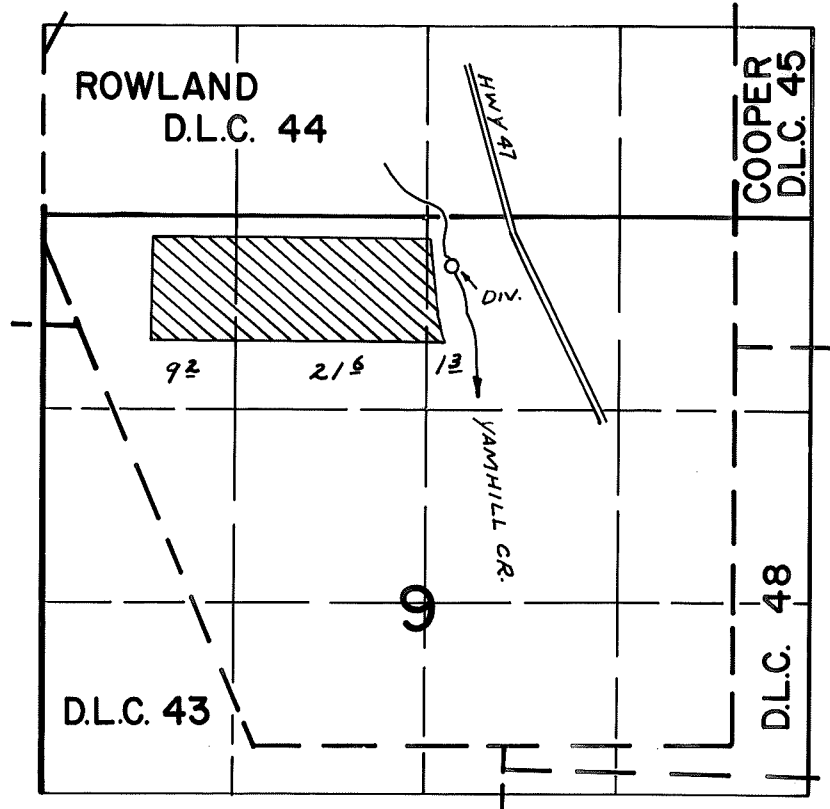

DIV. PT. LOC: 530' N. & 1930' W. FROM S.W. COR. COOPER D.L.C. 45

FINAL PROOF SURVEY UNDER

Application No. ~~49989~~... Permit No. ~~37596~~.....
IN NAME OF

.....CARL.....OWEN.....RASMUSSEN.....

Surveyed ~~OCT. 17~~. 19.79., by ~~R. G.~~ MURKEN