


T. 29S., R. 12W., W.M.

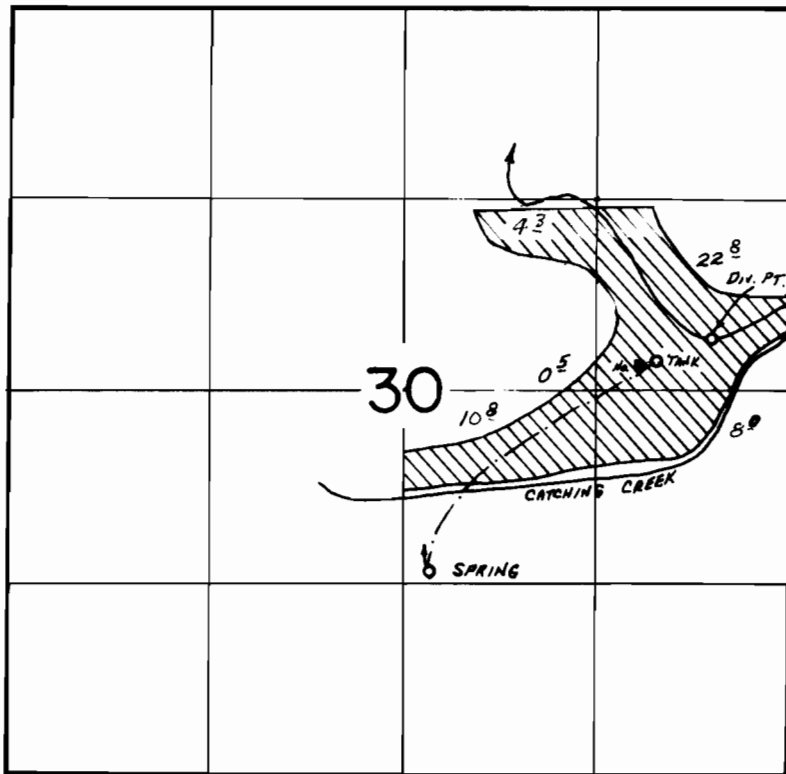

DIV. PTS. LOC.: CREEK - 360' N. & 530' W.; SPRING - 1240' S. & 2470' W.,
BOTH FROM E 1/4 COR. SEC. 30.

FINAL PROOF SURVEY
UNDER

Application No. 51242... Permit No. 37327.....
IN NAME OF

.....**VERAL E. TARNO**.....

Surveyed **JULY 21**... 1980., by **J.S. DONALDSON**