


T. 27 S., R. 13 W., W. M.

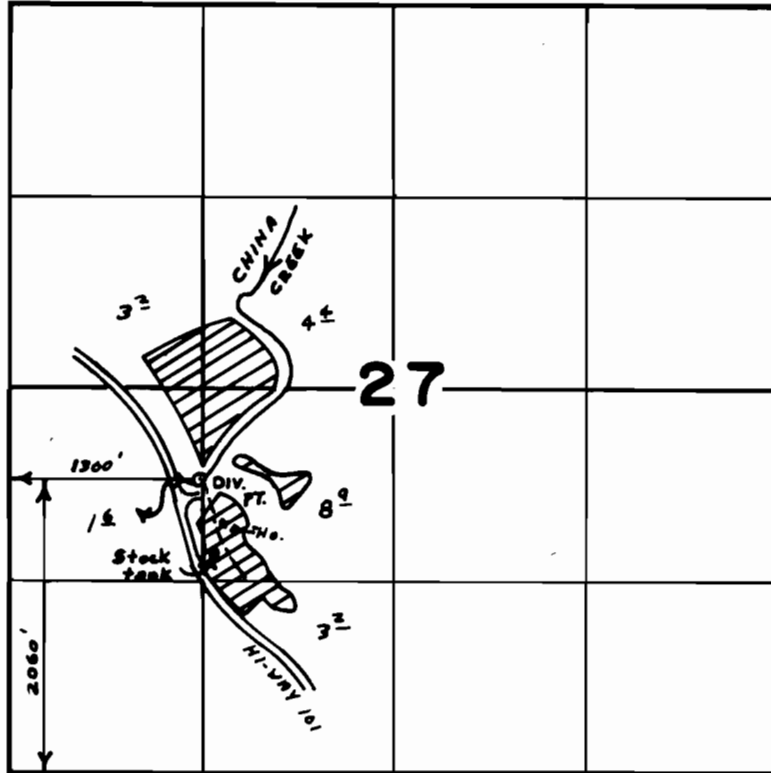

SCALE : 4" = 1 mile

FINAL PROOF SURVEY UNDER

Application No. 50757.. Permit No. 38333..
IN NAME OF

.....DONALD.....E.....WISELY.....

Surveyed SEPT. 12, 1979, by S. DONALDSON