


# T.30S. R.14W. W.M.

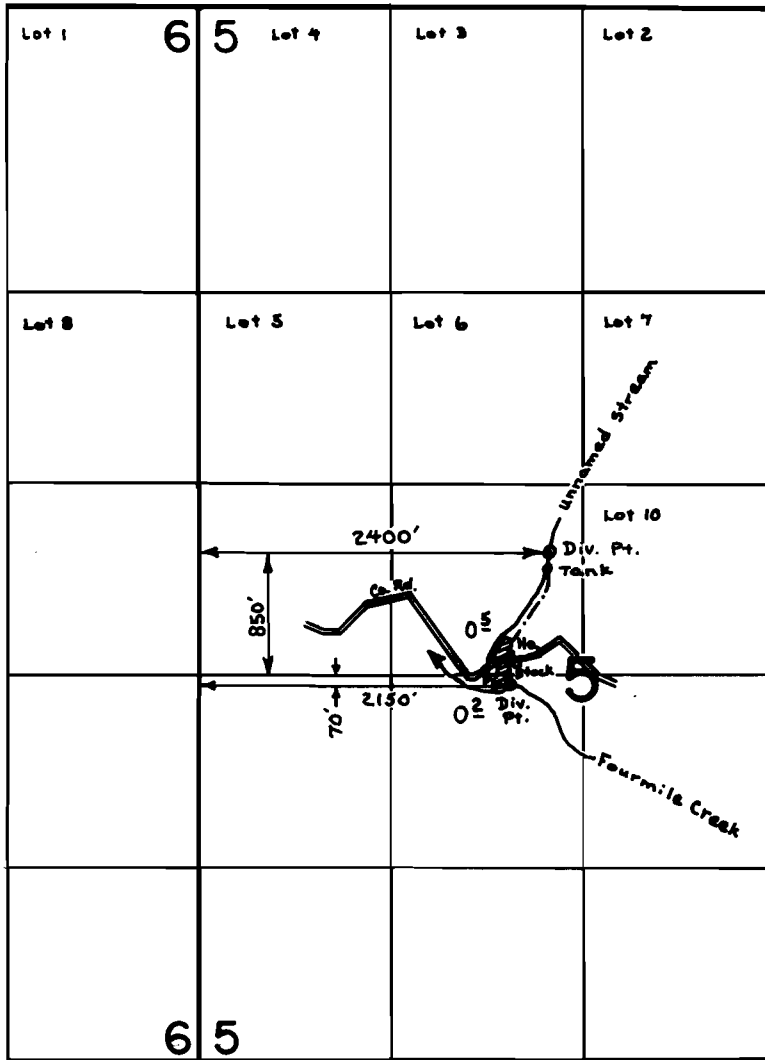

SCALE: 4" = 1 mile

## FINAL PROOF SURVEY UNDER

Application No. 54449 Permit No. 40848  
IN NAME OF

INEZ C. MILLER

Surveyed June 11, 1979, by S. Donaldson.