


T.29 S. R.12 W. W.M.

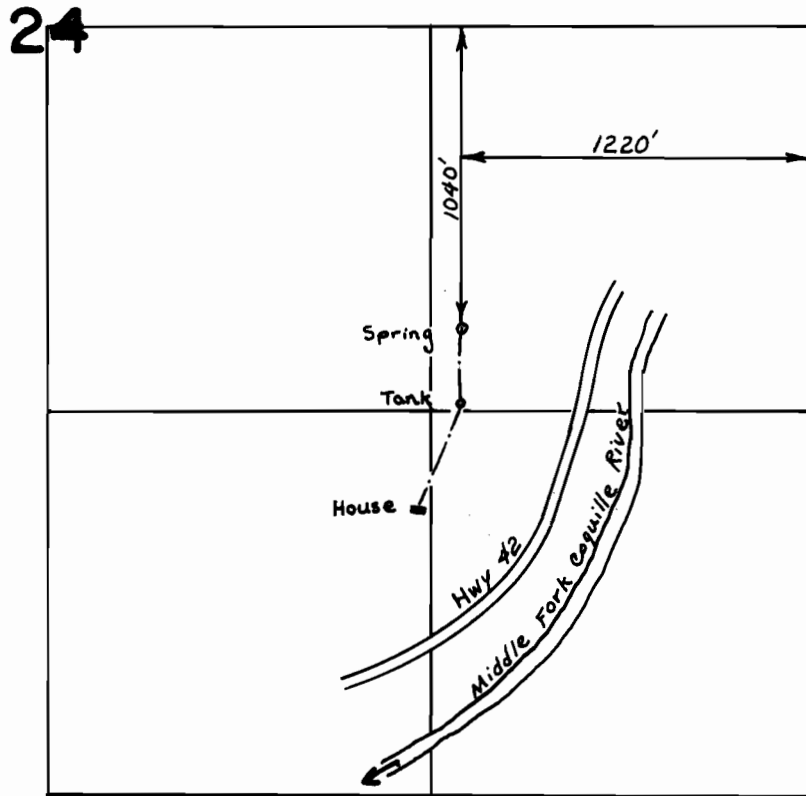

SCALE: 8" = 1 mile

FINAL PROOF SURVEY
UNDER

Application No. 56233 Permit No. 41860
IN NAME OF

SR & M. 1978

Surveyed Aug. 10 1978 by D.W. Sparks