


T.35 S.R.11 W.W.M.

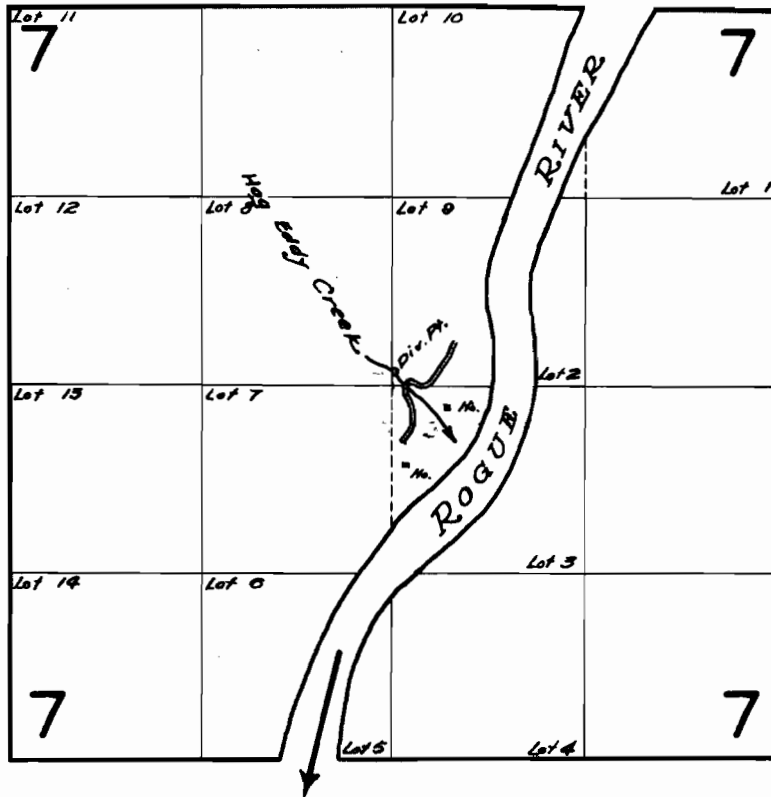

FINAL PROOF SURVEY UNDER

Application No. **32098**..... Permit No. **25923**.....
IN NAME OF
ARCHIE P. BOYD AND
WESLEY MORGAN

Surveyed *August 28 1961.*, by *C.O. Bartels.*