


T. 40S., R.13W., W.M.

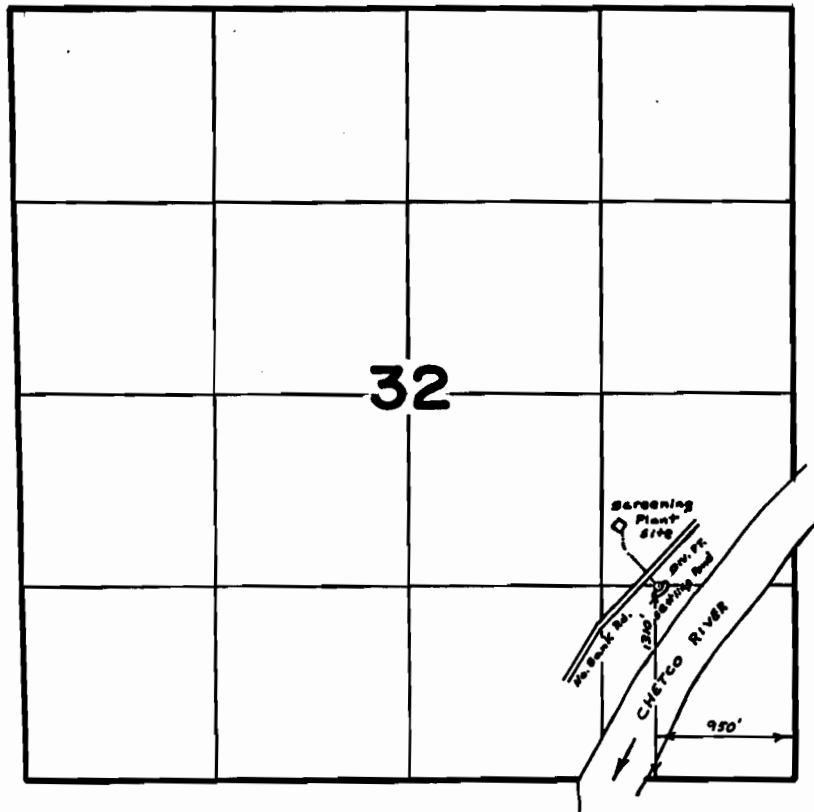

SCALE 4"=1mile

FINAL PROOF SURVEY
UNDER

Application No. 50235.. Permit No. 3.8.0.86..
IN NAME OF

FERRY...CREEK...ROCK...&...CONCRETE.. INC.

Surveyed August.15,1979, by S.Donaldson...