


T.32S. R.15W. W.M.

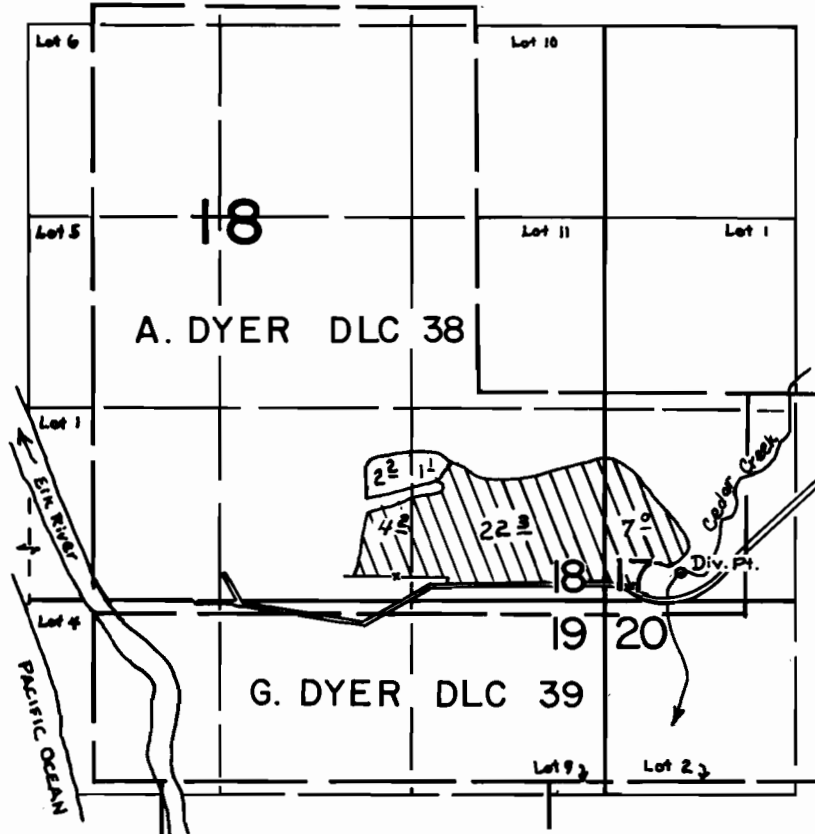

Div. Pt. Located: 200' N & 530' E from SW cor. of Sec. 17

SCALE: 4" = 1 mile

FINAL PROOF SURVEY
UNDER

Application No. 50869 Permit No. 38408
IN NAME OF

JOHN & GEORGINA WAHL

Surveyed June 26, 1979, by S. Donaldson