


T.32S. R.15W. W.M.

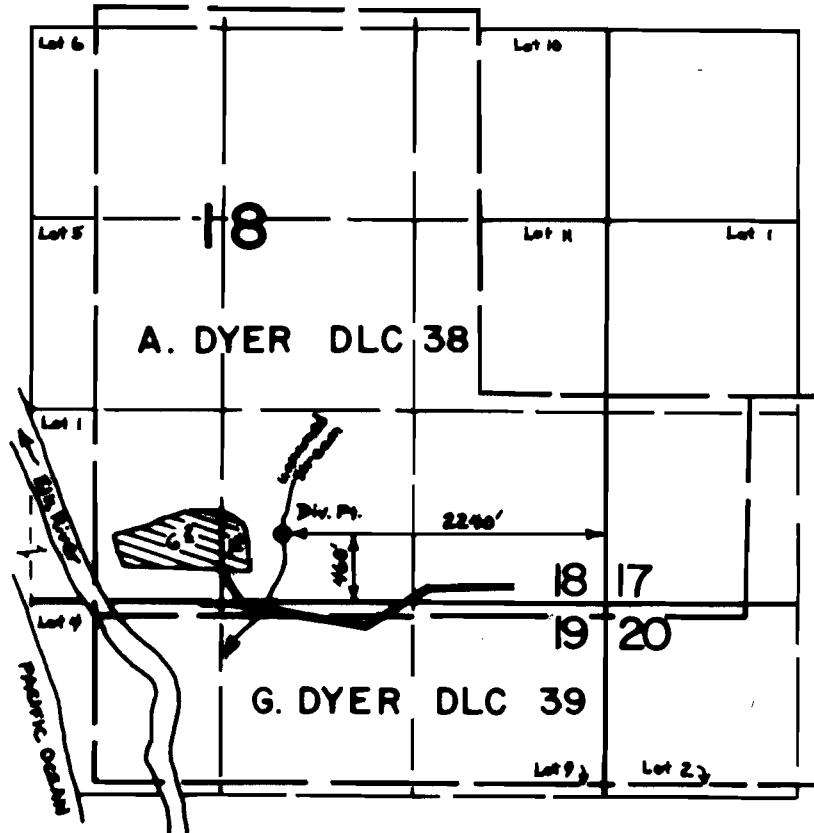

SCALE : 4" = 1 mile

**FINAL PROOF SURVEY**  
UNDER

Application No. 54429. Permit No. 40816.  
IN NAME OF

**GEORGINA WAHL**

Surveyed June 26, 1979, by S. Donaldson...