


T. 35 S., R. 14 W., W.M.

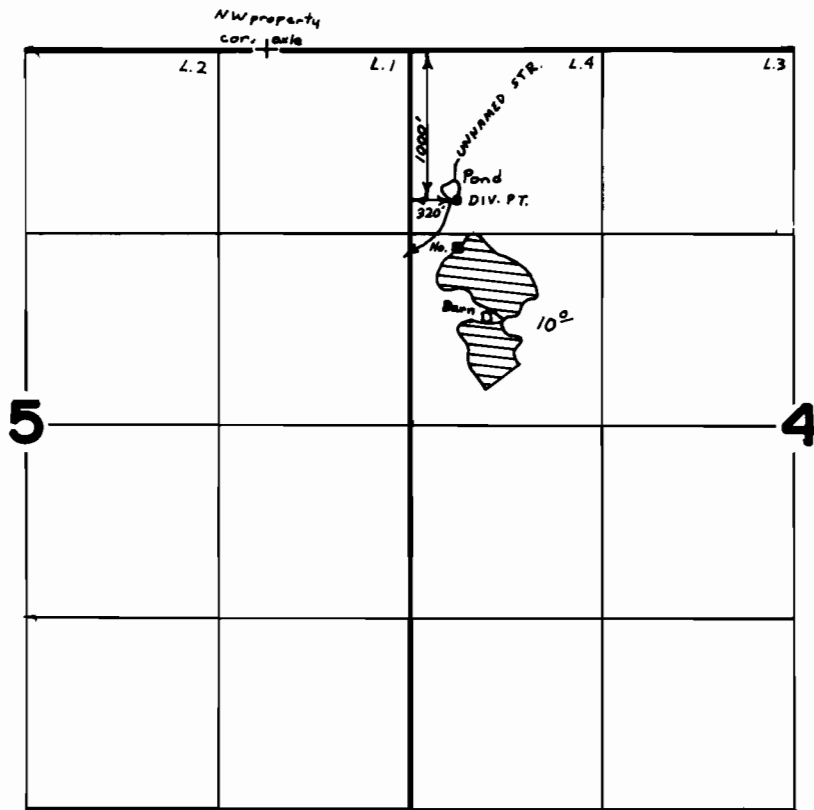

SCALE 4" = 1 mile

FINAL PROOF SURVEY
UNDER

Application No. 52871 Permit No. 39182
IN NAME OF

.....WAYNE J. KRIEGER.....

Surveyed July 24, 1979, by S. Donaldson.