


T. 32 S., R. 14 W., W. M.

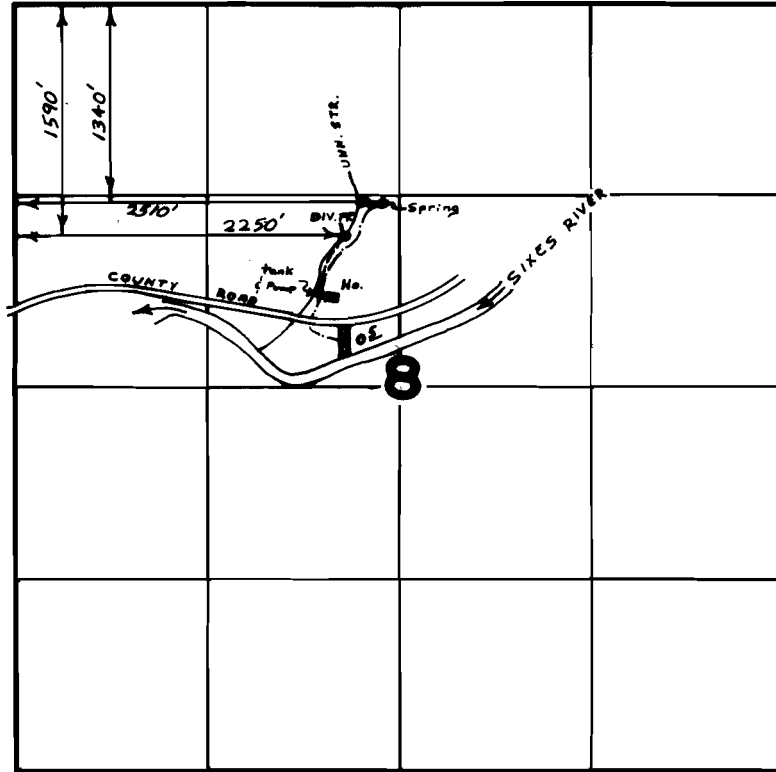

SCALE 4" = 1 mile

FINAL PROOF SURVEY UNDER

Application No. **54506** Permit No. **40880**...
IN NAME OF

WILLIAM...J...S...ANITA...E...HOWE....

Surveyed **June 28, 1979**, by **S..Donaldson....**