


T.32S. R.15W. W.M.

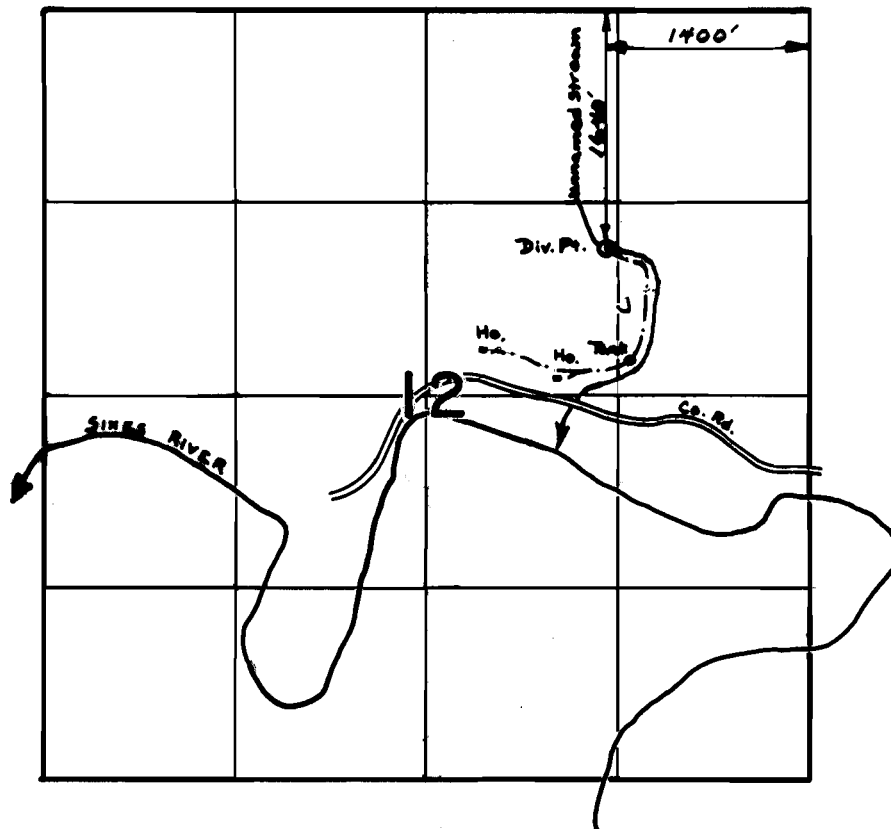

SCALE: 4" = 1 mile

FINAL PROOF SURVEY
UNDER

Application No. 56823 Permit No. 42683
IN NAME OF
JAMES F. HALL

Surveyed June 28, 1979, by S. Donaldson