


T. 37 S., R. 14 W., W.M.

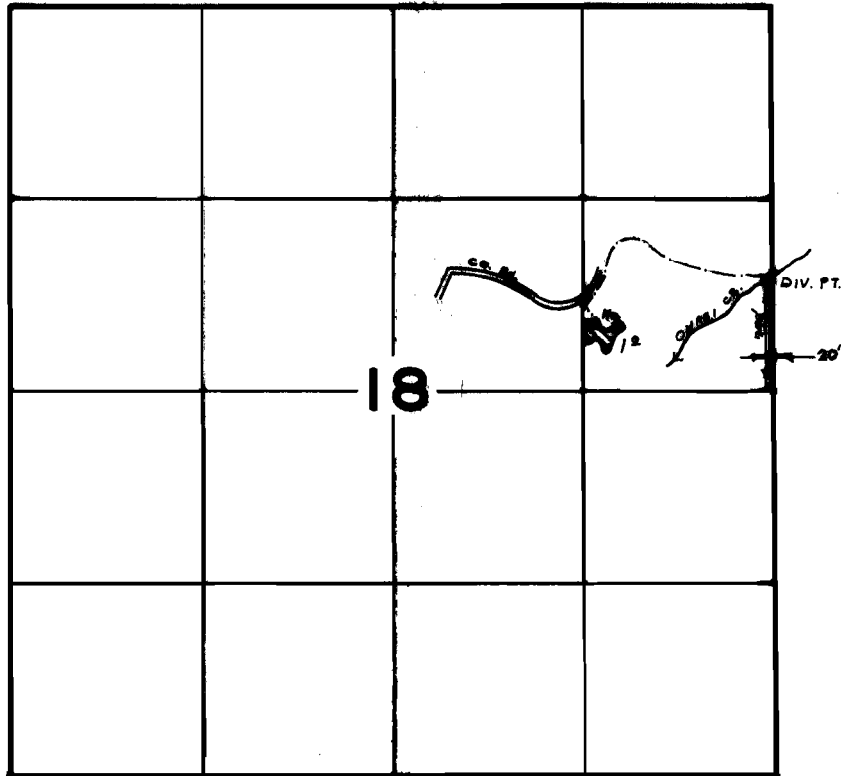

SCALE 4" = 1 mile

**FINAL PROOF SURVEY
UNDER**

Application No. 55936. Permit No. 43052.
IN NAME OF

.....CHARLES.....J.....PRICHARD.....

Surveyed July 25, 1979, by S. Donaldson..