

Application No. 58290 / 59812
 Permit No. 43904

RECEIVED

JAN 30 1979


WATER RESOURCES DEPT.
 SALEM, OREGON

SEE MAP 35 14 190

SW SEC. 20 T.35S. R.14W. W.M.
 CURRY COUNTY

1" = 400'

SEE MAP 35 14

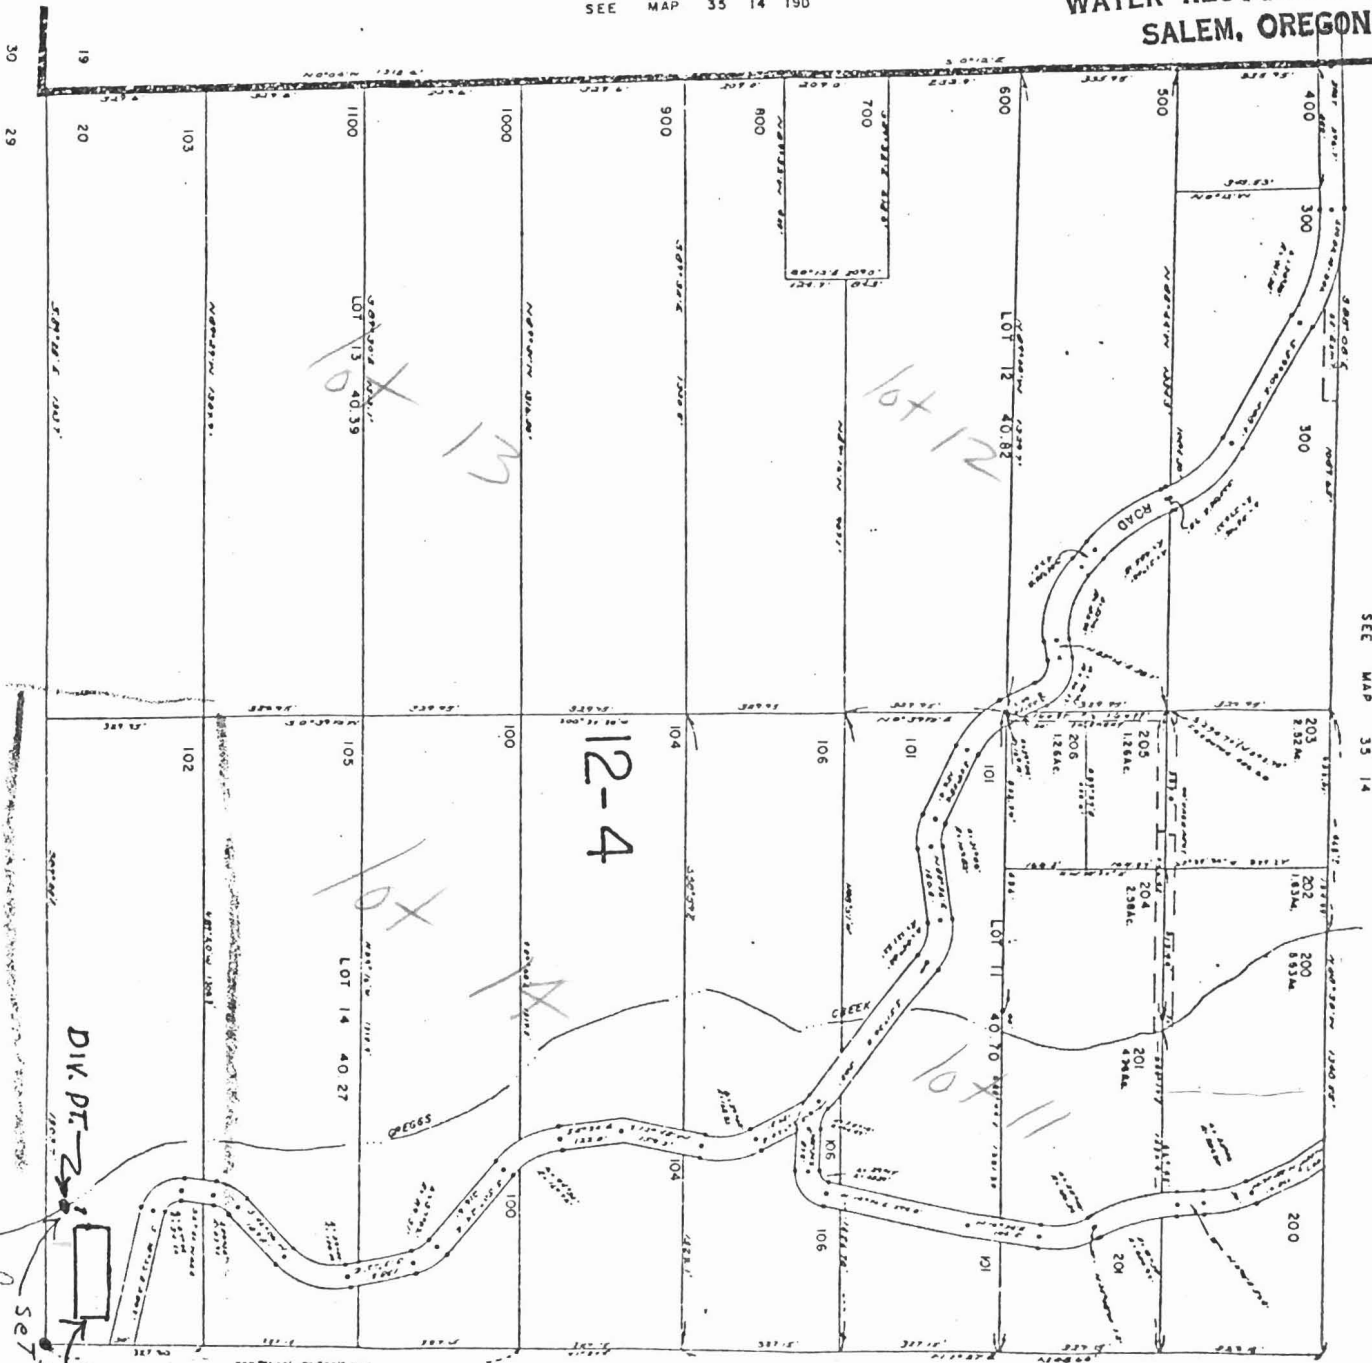

SEE MAP 35 14

DIV. PT. LOCATED
 40' N. & 290' W
 FROM S 1/4 COR.
 SEC. 20

Home
 SET UP TO Take water