T. 26S., R.5W., W.M.

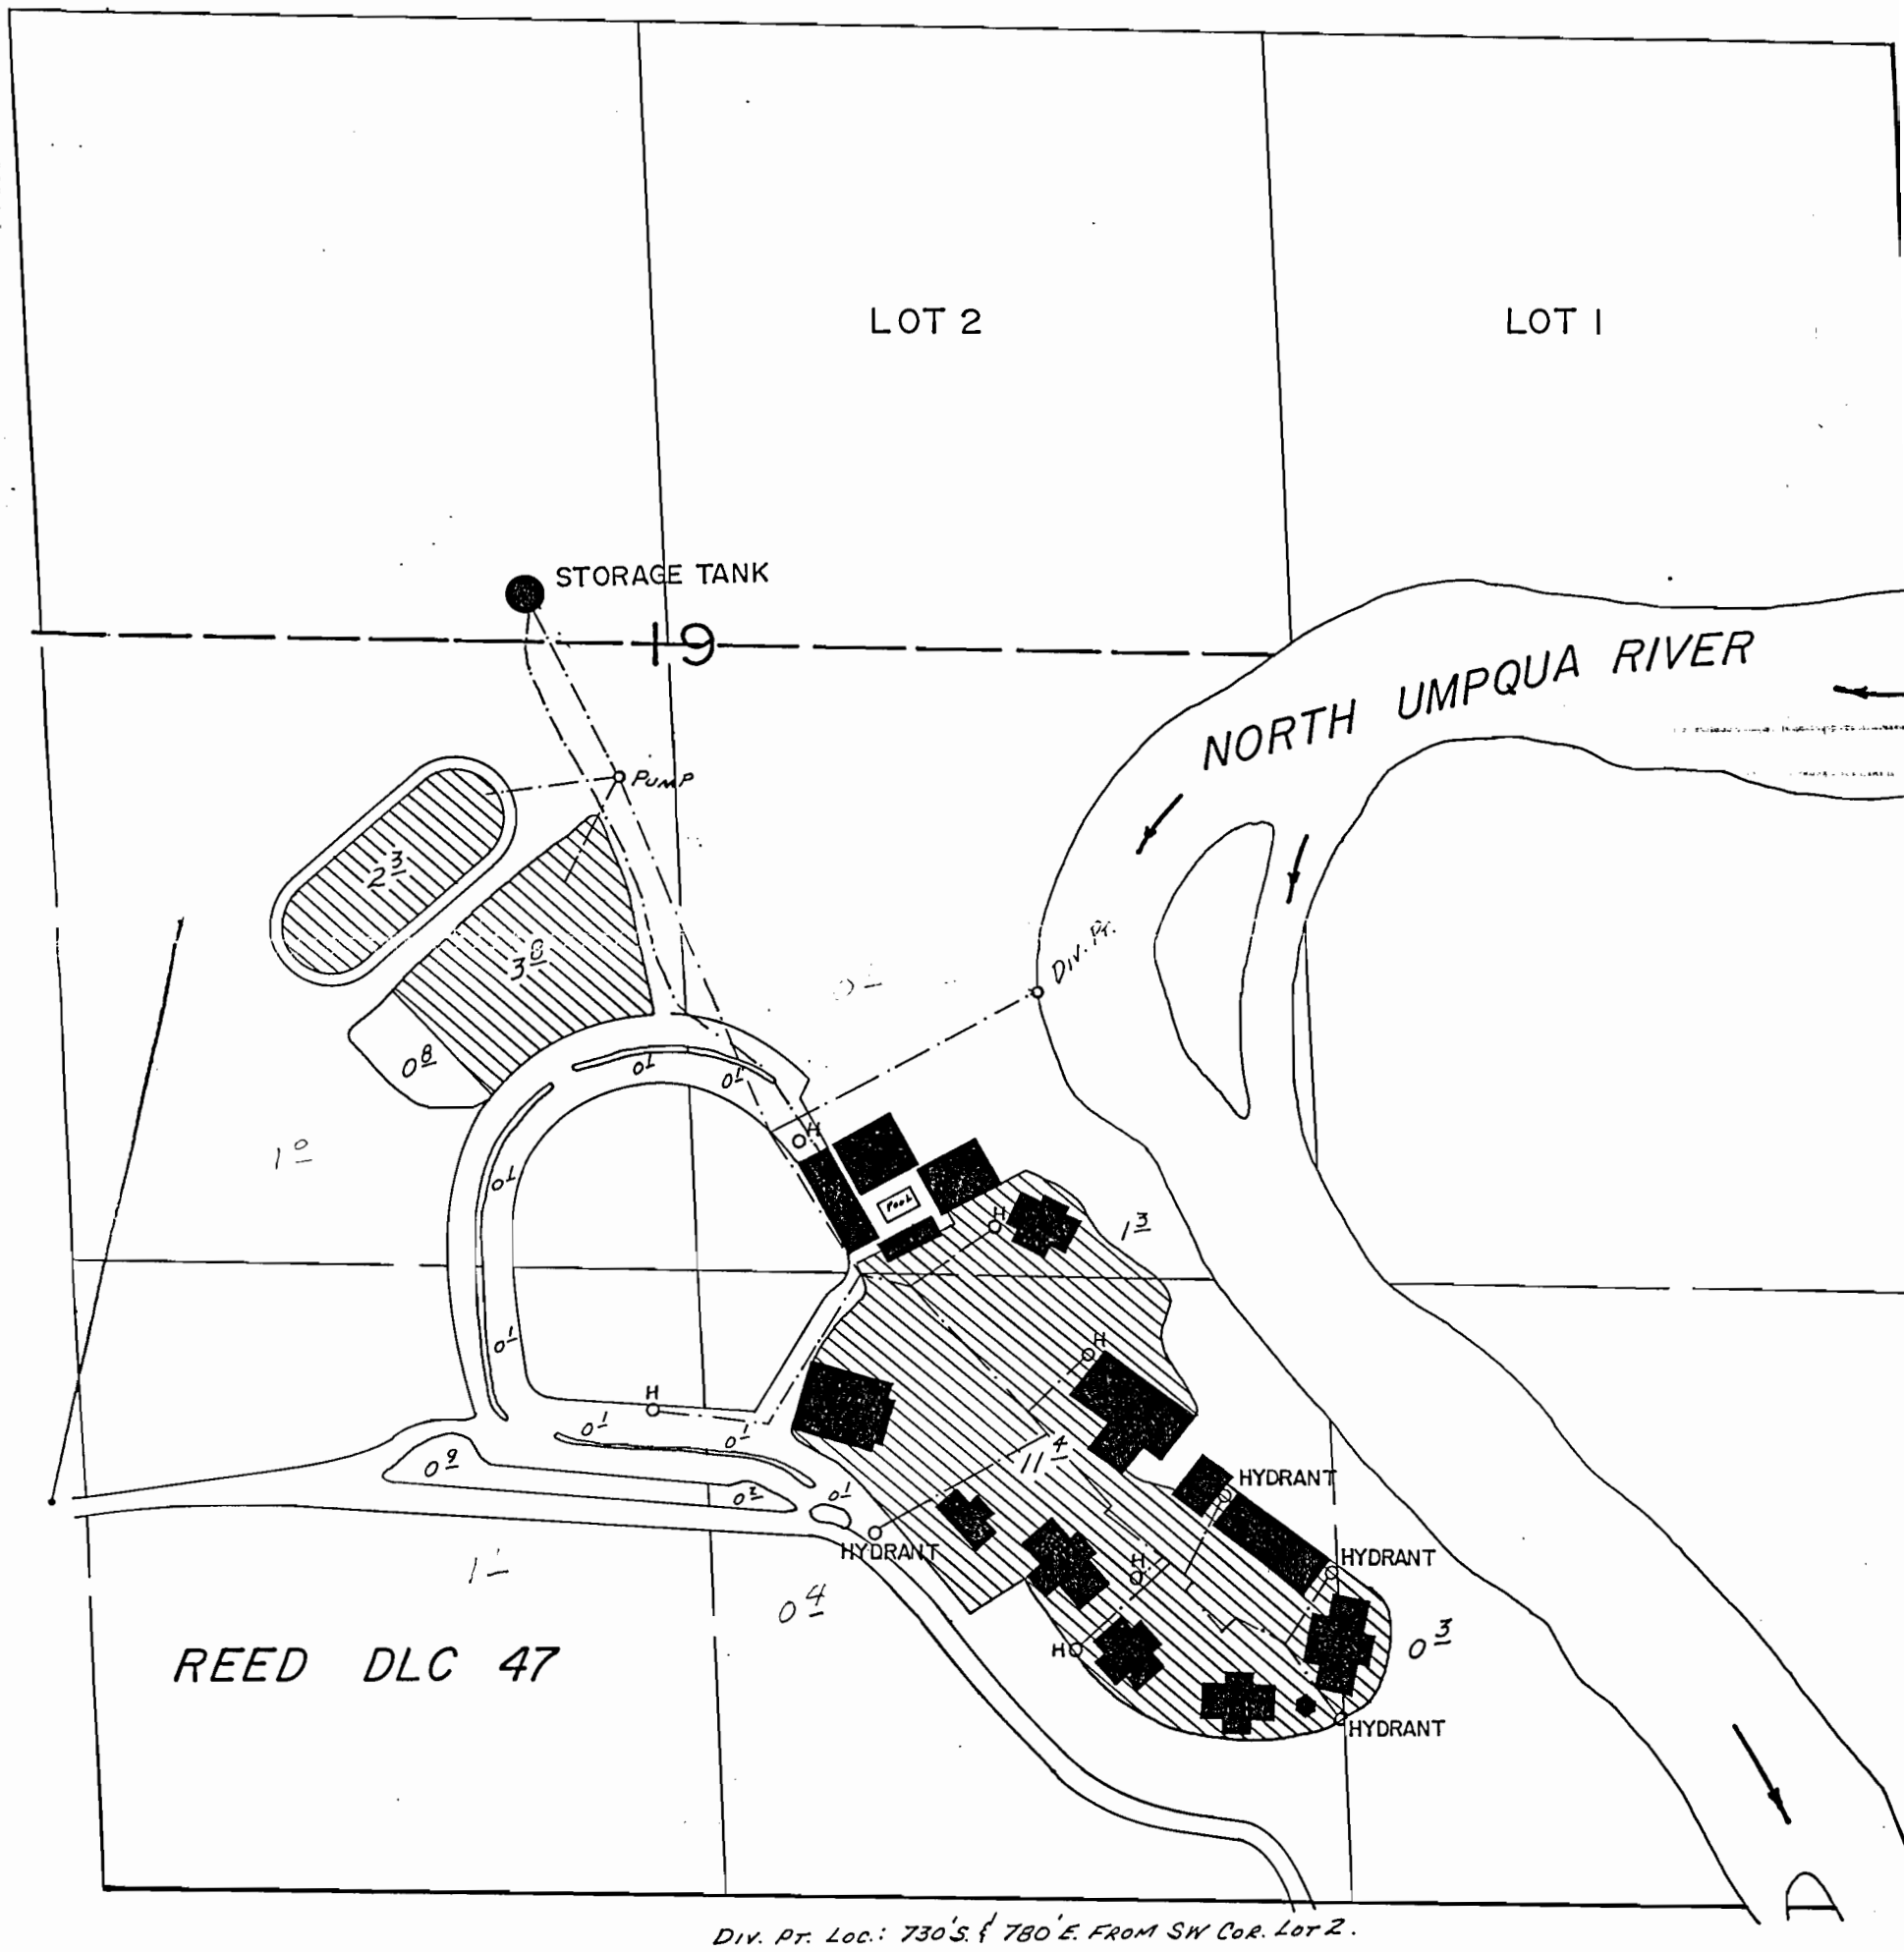


SCALE: 1" = 400'

# FINAL PROOF SURVEY
UNDER

Application No. 42951 Permit No. 32673
IN NAME OF

UMPQUA COMMUNITY COLLEGE

Surveyed MAR. 17 1980, by J. S. DONALDSON