


T. 34 S., R. 1 W., W. M.

Sec. 3

NE 1/4 NE 1/4

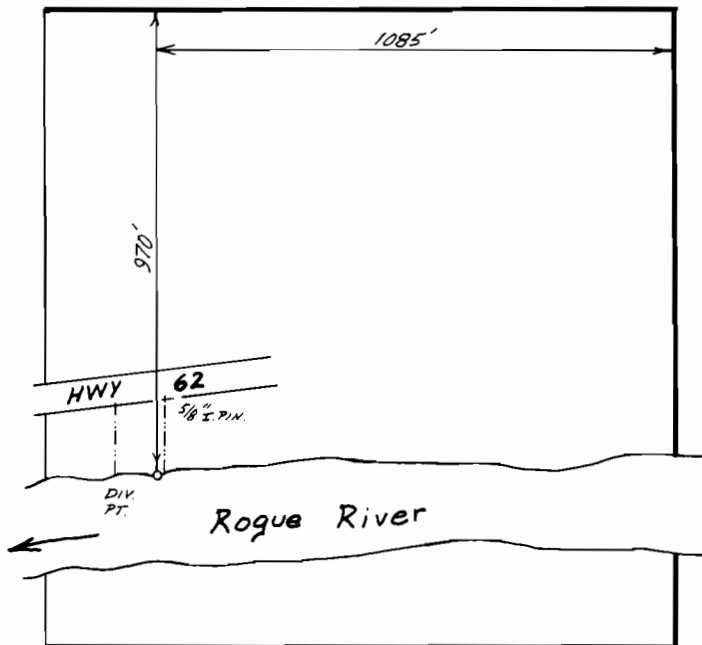

Scale 1" = 400'

FINAL PROOF SURVEY

UNDER

Transfer No. 2632

Application No. Permit No.

IN NAME OF

ROY T. LANNOM

Surveyed May 15, 1979, by B. R. SUND

Nov. 5, 1985 B.S. JAMES