


T. 34 S., R. 1 W., W. M.

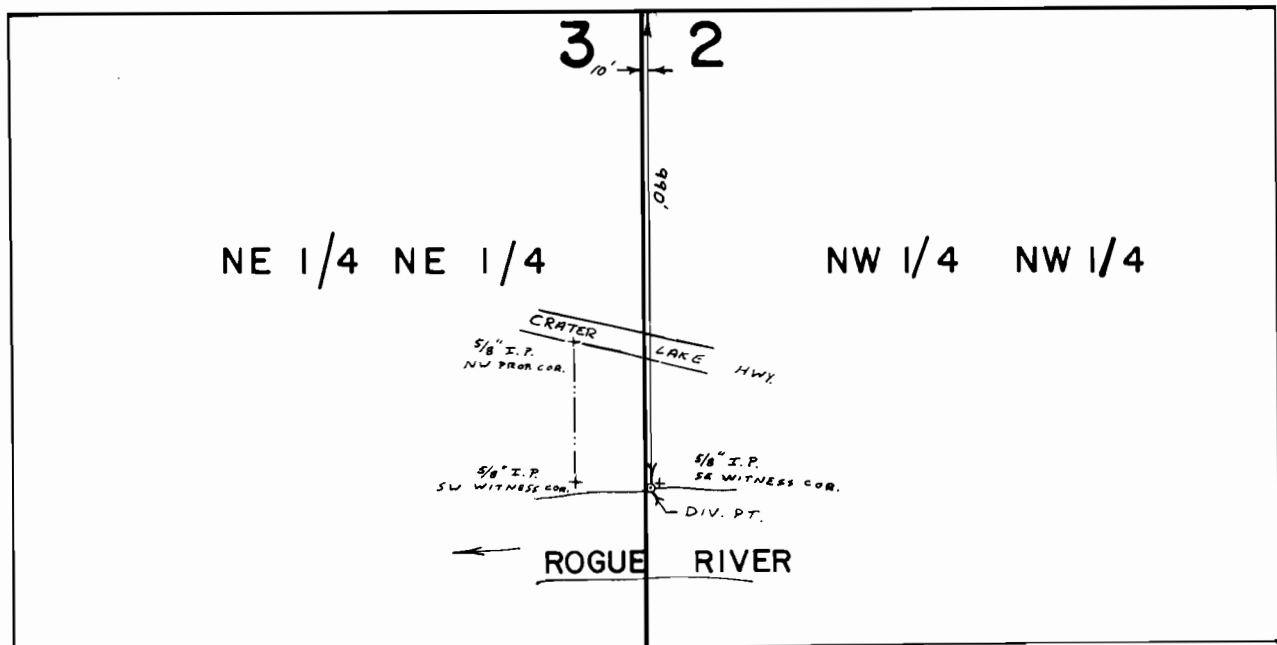

Scale 1" = 400'

FINAL PROOF SURVEY
UNDER

Transfer no. 3301

Application No. Permit No.
IN NAME OF

.....JAMES D. LOVE.....

Surveyed Sept. 10, 1981, by BRUCE R. SUND.