


T. 41S. R. 3W. W.M.

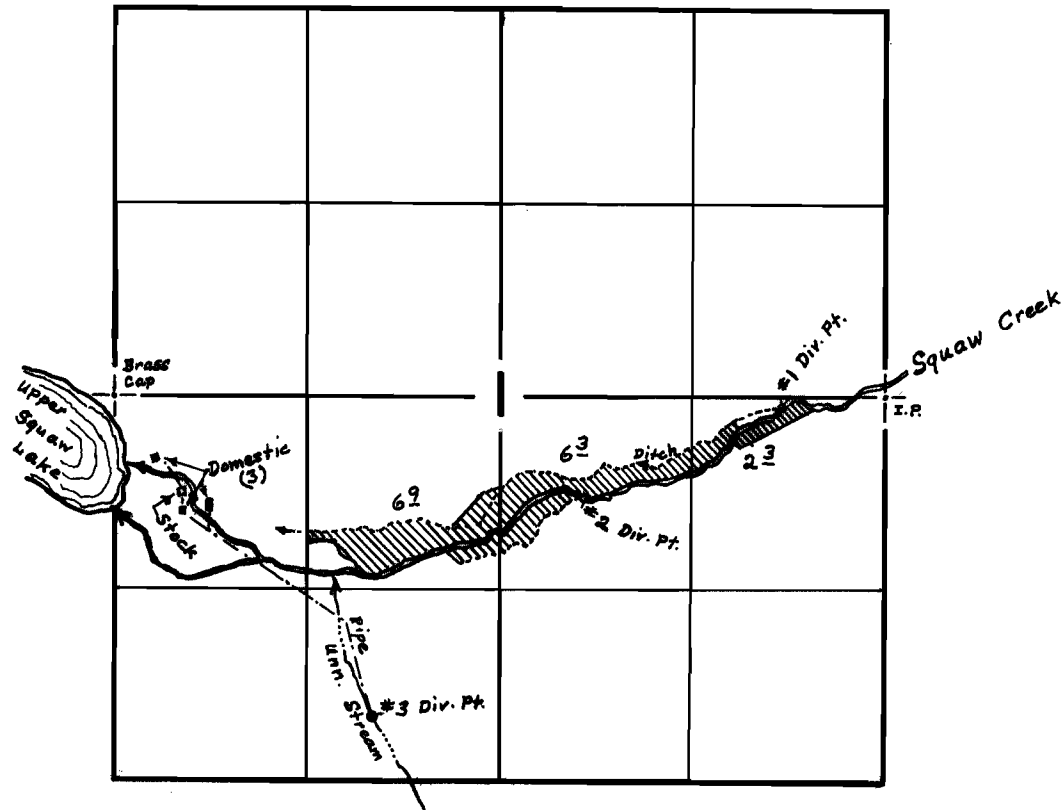

- #1 Diversion Point is 70'S. & 720'W. from E¹/₄ Cor. Sec. 1
- #2 Diversion Point is 700'S. & 2070'W. from E¹/₄ Cor. Sec. 1
- #3 Diversion Point is 2190'S. & 1760'E. from W¹/₄ Cor. Sec. 1

FINAL PROOF SURVEY
UNDER

Application No. **37844** Permit No. **28213**
IN NAME OF

A.C. Pierce

Surveyed **Jun. 17** 1971, by **D.C. Hendrix**