


T. 35 S., R. 1 W., W.M.

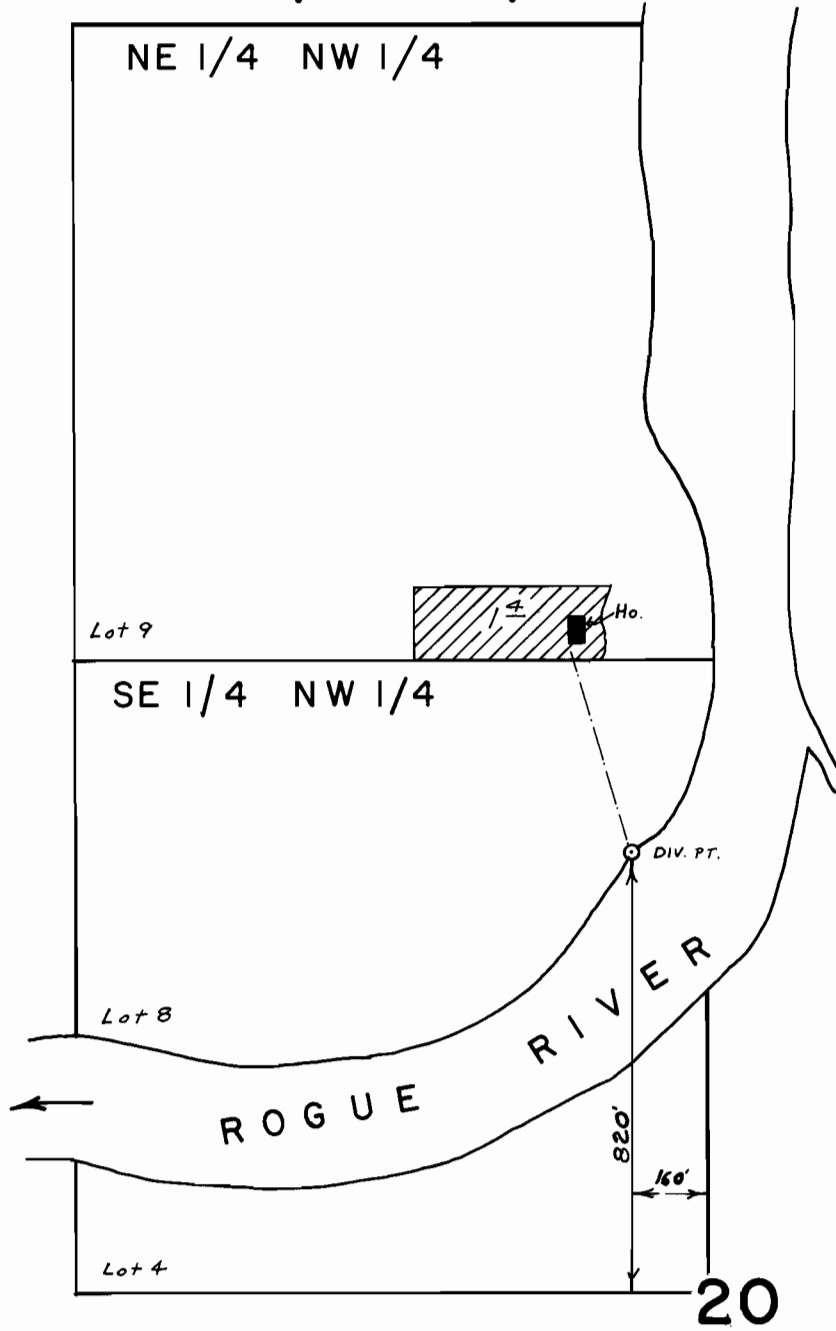

FINAL PROOF SURVEY
UNDER

Application No. 50513.. Permit No. 38143.....
IN NAME OF

HAROLD B./or ANNE C. RAIKES.

Surveyed Dec. 17., 1979, by B. R. SUND.....

Scale 1" = 400'