



T.32 S., R.3 E., W.M.

28

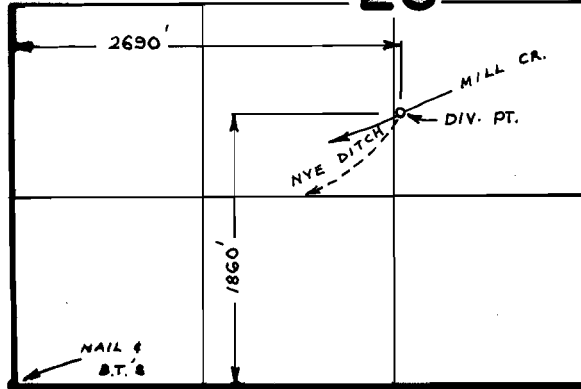

T.33 S., R.2 E., W.M.

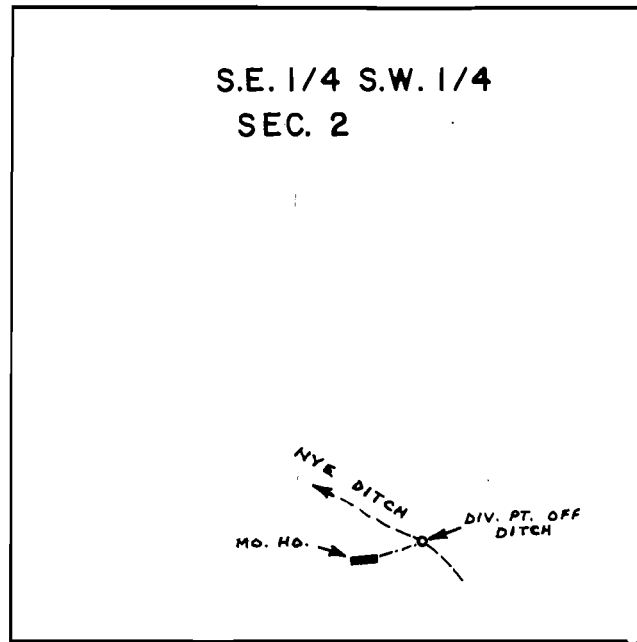

AC.  
5/4 cor.

SCALE : 1" = 400 FT.

**FINAL PROOF SURVEY**  
UNDER

Application No. 55973 Permit No. 42046  
IN NAME OF

.....EARL H. and WANDA G. LEASUE.....

Surveyed JUN. 7 1979, by B. SUND

D.H.M.  
P.T.S. - 1979-14-B